

P. R.  
K 53  
8-25-73

MISSISSIPPI  
BOARD OF WATER COMMISSIONERS  
416 North State Street  
Jackson, Mississippi 39201

CODED

WATER WELL DRILLERS LOG

8-25  
date well completed

1973

*Summit Well Drilling*  
firm name

Pearl River  
county well located

LANDOWNER: *Forest Plains Wood*  
*40 John Starkey*  
*Poplarville, Miss*  
(mailing address)

Description of formations encountered

from to

Clay	0	70
Sand	70	85
Clay	85	115
Sand	115	155
Clay	155	170
Sand	170	230
Clay	230	260
Sand	260	300
Clay	300	470
Sand	470	567

WELL LOCATION:

sec. 32 T 30 N R 17 E  
*14* miles West of Poplarville  
(distance) (direction) (nearest town)

WELL PURPOSE: *Domestic*  
(home, irrigation, municipal, industrial)

WELL COMPLETION DATA:

- (1) diameter (inches) 4"
- (2) total depth (feet) 567
- (3) static water level (feet) 60" below above top of ground.
- (4) casing sch. 40 P.V.C. 547  
(material) (depth)  
4" if telescope see back.  
(size)
- (5) screen 20" 547  
(length) (depth to top)  
4" P.V.C.  
(size) (material)
- (6) pump 3 h.p. 3600 P.h.  
(HP) (yield gpm)  
E. Leo.  
(type power)
- (7) electric log no.  
(yes or no)

CODED

(organization running log)


(8) how well bottom plugged Sand Sheet

DEC 26 1973

DRILLERS REMARKS:

If well telescopes please sketch and show depths.

GROUND LEVEL

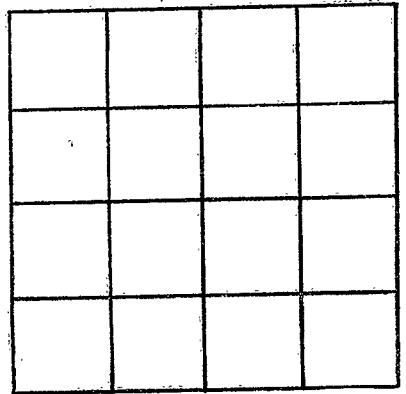

SECTION \_\_\_\_\_

Please indicate well location X.

ADDITIONAL INFORMATION

If more than one screen,  
show locations of each on sketch.