

Pearl River  
K 54  
1-10-74

MISSISSIPPI  
BOARD OF WATER COMMISSIONERS  
416 North State Street  
Jackson, Mississippi 39201

CODED

WATER WELL DRILLERS LOG

1-10-74 date well completed  
Earl Penton water well serv. Pearl River firm name  
county well located


LANDOWNER:	description of formations encountered	from	to
Ceciel J Higdon P.O. Box 116 Miss. (mailing address)			
WELL LOCATION:	Gravel	16	19
sec. 12 T 3 N R 17 E 12 miles west of Poplarville (distance) (direction) (nearest town)	Red Clay + sd.	19	38
WELL PURPOSE: Home (home, irrigation, municipal, industrial)	Blue & white clay	38	118
WELL COMPLETION DATA:	Coarse Red. sd.	118	146
(1) diameter (inches) 4 5/8			
(2) total depth (feet) 146'			
(3) static water level (feet) 29' below top of ground.			
(4) casing P.V.C. 1 1/4" (material) (depth) 2" (size) If telescope see back.			
(5) screen 5' 1 1/4" (length) (depth to top) 2" P.V.C. (size) (material)			
(6) pump 1/2 450 g.p.m. (HP) (yield gpm) Elect. (type power)			
(7) electric log NO (yes or no)			
(organization running log)			
(8) how well bottom plugged shoe			
DRILLERS REMARKS:			

CODED

APR 10 1974

If well telescopes please sketch and show depths.

GROUND LEVEL

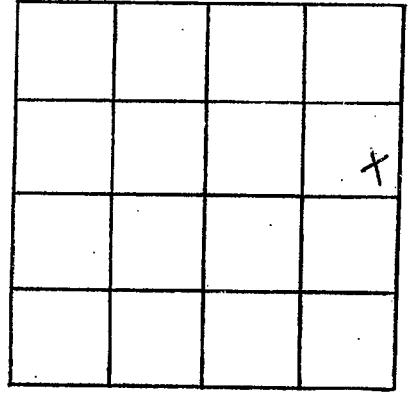

SECTION 12

Please indicate well location X.

ADDITIONAL INFORMATION

If more than one screen,  
show locations of each on sketch.