

Pearl River
K55
5-23-74

MISSISSIPPI
BOARD OF WATER COMMISSIONERS CODED
416 North State Street
Jackson, Mississippi 39201

WATER WELL DRILLERS LOG

May 23 1974 Earley Staffed Water Well Pearl River Co.
date well completed firm name county well located

LANDOWNER: Willis Wheat
Rt. 3, Box C218
Poplarville, Miss
(mailing address)

description of formations encountered	from	to
<u>top soil</u>	<u>0</u>	<u>3</u>
<u>sand + gravel</u>	<u>4</u>	<u>20</u>

WELL LOCATION:
sec. 11 T. 3 N R. 17 E
1 1/2 miles W of Whiteford
(distance) (direction) (nearest town)

WELL PURPOSE:
(home, irrigation, municipal, industrial)

- WELL COMPLETION DATA:
- (1) diameter (inches) 4"
 - (2) total depth (feet) 30ft
 - (3) static water level (feet) 12' below above top of ground.
 - (4) casing 4 20'
(material) (depth)
4" if telescope see back.
(size)
 - (5) screen 10ft 20'
(length) (depth to top)
4" plastic
(size) (material)
 - (6) pump _____
(HP) (yield gpm)
(type power)
 - (7) electric log _____
(yes or no)
(organization running log)
 - (8) how well bottom plugged B. W. O.


CODED

RECEIVED
AUG - 5 1974

DRILLERS REMARKS:
Clovie Duncan

If well telescopes please sketch and show depths.

GROUND LEVEL

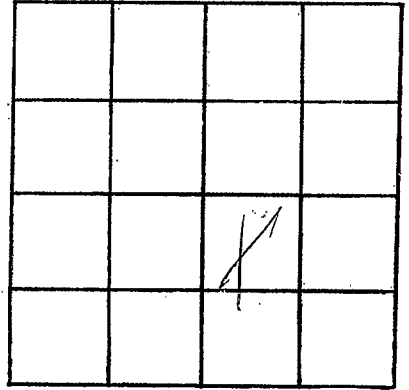

SECTION _____

Please indicate well location X.

ADDITIONAL INFORMATION

If more than one screen,
show locations of each on sketch.