

Pearl River
K56
6-3-74

MISSISSIPPI
BOARD OF WATER COMMISSIONERS
416 North State Street
Jackson, Mississippi 39201

CODED

WATER WELL DRILLERS LOG

June 3, 1974 Lumpkin Wellser Pearl River Co.
date well completed firm name county well located

LANDOWNER: Melvin Morgan

Description of formations encountered	from	to
Clay	0	60
Sand	60	85
Clay	85	140
Sand	140	170

Wiggins, Miss.
(mailing address)

WELL LOCATION:

sec. 31 T 3 N R 17 E
3 S 17 W
miles of
(distance) (direction) (nearest town)

WELL PURPOSE: Home
(home, irrigation, municipal, industrial)

WELL COMPLETION DATA:

- (1) diameter (inches) 2"
- (2) total depth (feet) 170'
- (3) static water level (feet) 100 below above top of ground.
- (4) casing P.V.C. 160
(material) (depth)
2"
(size) If telescope see back.
- (5) screen 5' 105'
(length) (depth to top)
2"
(size) P.V.C.
(material)
- (6) pump 1 1/2 P 450
(HP) (yield gpm)
Elec.
(type power)
- (7) electric log No
(yes or no)

CODED

(organization running log)


(8) how well bottom plugged Dr. L. Shab.

DRILLERS REMARKS:

RECEIVED
AUG - 8 1974

If well telescopes please sketch and show depths.

GROUND LEVEL

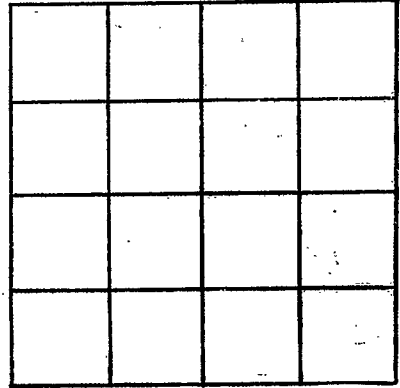

SECTION _____

Please indicate well location X.

ADDITIONAL INFORMATION

If more than one screen, show locations of each on sketch.