

Pearl River
K 57
6-12-75

MISSISSIPPI
BOARD OF WATER COMMISSIONERS
416 North State Street
Jackson, Mississippi 39201

CODED

WATER WELL DRILLERS LOG

6-12 date well completed 25 Lempkin Well Ser - Pearl River firm name Pearl River county well located

LANDOWNER: Mr. Jerry Vanderford
Box 73155 Metairie, La. (mailing address)

description of formations encountered	from	to
Clay	0	80
Sand	80	126

WELL LOCATION: sec 20 T 3 N R 17 E 13V
14 miles West of Poplarville (distance) (direction) (nearest town)

WELL PURPOSE: Home (home, irrigation, municipal, industrial)

- WELL COMPLETION DATA:
- (1) diameter (inches) 2"
 - (2) total depth (feet) 126'
 - (3) static water level (feet) 80' below top of ground.
 - (4) casing P.V.C. 120' (material) (depth)
2" (size) If telescope see back.
 - (5) screen 6' 120' (length) (depth to top)
2" P.V.C. (size) (material)
 - (6) pump 1 250 (HP) (yield gpm)
Elec. (type power)
 - (7) electric log No (yes or no)
No. (organization running log)
 - (8) how well bottom plugged Sand Shells

RECEIVED
RECEIVED


JUN 14 1975
JUN 14 1975

DRILLERS REMARKS:

MISS. BD. OF WATER COMM

If well telescopes please sketch and show depths.

GROUND LEVEL

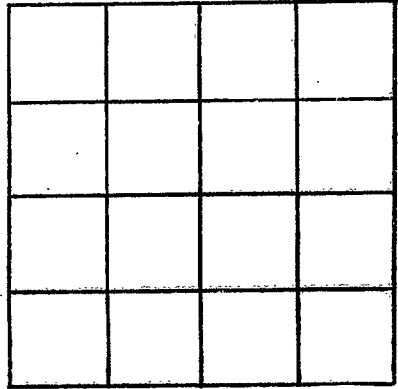

SECTION _____

Please indicate well location X.

ADDITIONAL INFORMATION

If more than one screen,
show locations of each on sketch.