


Pearl River  
K 58  
8-9-75

MISSISSIPPI  
 BOARD OF WATER COMMISSIONERS  
 416 North State Street  
 Jackson, Mississippi 39201

WATER WELL DRILLERS LOG


8-9 date well completed      75 Lumphin Well Dr. firm name      Pearl River county well located

LANDOWNER:	description of formations encountered	from	to
<u>Mr. Mike Harris</u>			
<u>Rt. Poplarville, Ms.</u> (mailing address)		<u>Clay</u>	<u>0</u> <u>20</u>
<b>WELL LOCATION:</b>		<u>Sand</u>	<u>20</u> <u>60</u>
sec. <u>3</u> T. <u>3</u> N. R. <u>17</u> E <u>10</u> miles <u>W</u> of <u>Poplarville</u> (distance) (direction) (nearest town)		<u>Clay</u>	<u>60</u> <u>85</u>
<b>WELL PURPOSE:</b> <u>Home</u> (home, irrigation, municipal, industrial)		<u>Sand</u>	<u>85</u> <u>132</u>
<b>WELL COMPLETION DATA:</b>			
(1) diameter (inches) <u>2"</u>			
(2) total depth (feet) <u>132'</u>			
(3) static water level (feet) <u>85'</u> below top of ground.			
(4) casing <u>P.V.C.</u> , <u>127'</u> (material) (depth) <u>2"</u> (size) If telescope see back.			
(5) screen <u>5'</u> , <u>127'</u> (length) (depth to top) <u>2"</u> , <u>P.V.C.</u> (size) (material)			
(6) pump <u>1/2</u> , <u>300</u> (HP) (yield gph) <u>Elec.</u> (type power)			
(7) electric log <u>No.</u> (yes or no) <u>No.</u> (organization running log)			
(8) how well bottom plugged <u>Sealed</u>			
<b>DRILLERS REMARKS:</b>			

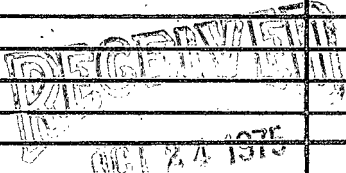

If well telescopes please sketch and show depths.

GROUND LEVEL

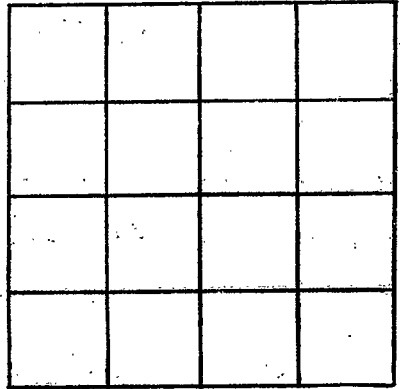

SECTION \_\_\_\_\_

Please indicate well location X.

ADDITIONAL INFORMATION

If more than one screen,  
show locations of each on sketch.