

MISSISSIPPI DEPARTMENT OF NATURAL RESOURCES

Bureau of Land and Water Resources

Southport Mall

P.O. Box 10631

BUD PENTON & SON  
WATER WORKS, JACKSON, MISSISSIPPI 39209

WATER WELL DRILLERS LOG

CARRIERS, MS 39426  
PHONE 798-5324

CODED

Pearl River  
K 59  
7/30/81

7/30 1981 date well completed  
firm name \_\_\_\_\_  
Pearl River county well located

LANDOWNER: Mr. Ned Soren

R.T. 1 Box 170 Poplarville

(mailing address)

WELL LOCATION:

sec. 12 T 3 N R. 17 E  
176 1/2 miles W of Poplarville  
(distance) (direction) (nearest town)

WELL PURPOSE: home  
(home, irrigation, municipal, industrial)

WELL COMPLETION DATA:

(1) diameter (inches) 2"

(2) total depth (feet) 566

(3) static water level (feet) 8 ft below above top of ground.

(4) casing PVC, 566  
(material) (depth)

(size) if telescope see back.

(5) screen 2x20, 546  
(length) (depth to top)

12, PVC  
(size) (material)

(6) pump 70  
(HP) (yield gpm)

(type power)

(7) electric log 70  
(yes or no)

(organization running log)

(8) how well bottom plugged 1/2 in

DRILLERS REMARKS:

description of formations encountered	from	to
<u>Red shale</u>	<u>0</u>	<u>30</u>
<u>White sand</u>	<u>30</u>	<u>65</u>
<u>Blue shale</u>	<u>65</u>	<u>175</u>
<u>Blue sand</u>	<u>175</u>	<u>257</u>
<u>Blue shale</u>	<u>257</u>	<u>500</u>
<u>Gray sand</u>	<u>500</u>	<u>566</u>

CODED


DEPT. OF NATURAL RESOURCES  
BUREAU OF LAND & WATER RESOURCES

SEP 29 1981

RECEIVED

If well telescopes please  
sketch and show depths.

GROUND LEVEL

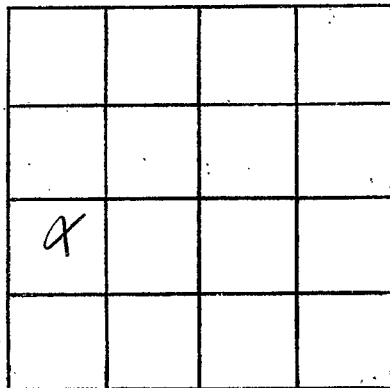

SECTION \_\_\_\_\_

Please indicate well location X.

ADDITIONAL INFORMATION

If more than one screen,  
show locations of each on sketch.