

MISSISSIPPI DEPARTMENT OF NATURAL RESOURCES

Bureau of Land and Water Resources

Southport Mall

P.O. Box 10631

Jackson, Mississippi 39209

CODED

WATER WELL SERVICE DRILLERS LOG

ROUTE 3 BOX 41

CARRIERE, MS 39426

PHONE 765-0324

Pearl River
R 60
7/17/81

7/17 1981
 date well completed

Pearl River
 county well located

LANDOWNER: Caillouet, Tom
Peppersville miss.
W.W. 2 E
 (mailing address)

WELL LOCATION:
 sec. 14 T 73 N R 17 E
0 miles W of Peppersville
 (distance) (direction) (nearest town)

WELL PURPOSE: farm
 (home, irrigation, municipal, industrial)

WELL COMPLETION DATA:

(1) diameter (inches) 4"

(2) total depth (feet) 1177

(3) static water level (feet) 90' below above top of ground.

(4) casing galv. 1177
 (material) (depth)
no if telescope see back.
 (size)

(5) screen 4x20 113-7
 (length) (depth to top)
10" S.S. steel
 (size) (material)

(6) pump 5 102
 (HP) (yield gpm)
Elect
 (type power)

(7) electric log no
 (yes or no)

(organization running log)

(8) how well bottom plugged hard

DRILLERS REMARKS:

description of formations encountered	from	to
Red shale	0	30
Red sand	30	60
White shale	60	150
White sand	150	300
Blue shale	300	560
Blue sand	560	630
Blue shale	630	850
Gray sand	850	935
Blue shale	935	1100
Gray sand	1100	1176

CODED


DEPT. OF NATURAL RESOURCES
 BUREAU OF LAND & WATER RESOURCES

SEP 29 1981

RECEIVED

If well telescopes please sketch and show depths.

GROUND LEVEL

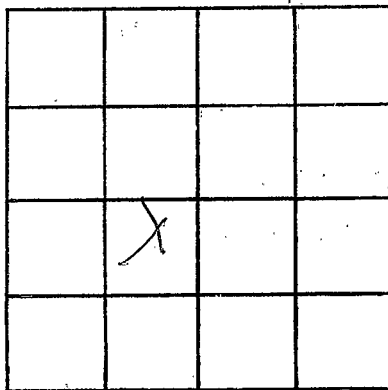

SECTION _____

Please indicate well location X.

ADDITIONAL INFORMATION

If more than one screen, show locations of each on sketch.