

MISSISSIPPI DEPARTMENT OF NATURAL RESOURCES

Bureau of Land and Water Resources

Southport Mall

P.O. Box 10631

Jackson, Mississippi 39209

WATER WELL DRILLERS LOG

Griner Drilling Service, INC.

Pearl River

PEARL RIVER
K 63

CODED

5-24-86 date well completed

Griner Drilling Service, INC. firm name

Pearl River county well located

LANDOWNER:

EXXON COMPANY U.S.A.
P.O. Box 60006
New Orleans, La. 70160
(mailing address) 0006

description of formations encountered

from

to

clay, little sand 0 90

sand, gravel 90 357

clay 357 360

WELL LOCATION: 1600'S + 1575'W

sec. 9 T 3 N R 17 E of

No. 5 NW 1/4 of Poplarville

distance (direction) (nearest town)

WELL PURPOSE: oilfield rig

home, irrigation, municipal, industrial

WELL COMPLETION DATA:

(1) diameter (inches) 4"

(2) total depth (feet) 360'

(3) static water level (feet) 50' below top of ground.

(4) casing steel, 360' (material), (depth)

4" (size) if telescope see back.

(5) screen 20', 340' (length), (depth to top)

4" stainless (size), steel (material)

(6) pump 5 (HP), 90 (yield gpm)

230 volt 3 phase (type power)

(7) electric log (yes or no)

(organization running log)

(8) how well bottom plugged 4" wood plug, back wash valve

DRILLERS REMARKS:

CODED

No. 2. water well drilled on location


RECEIVED

JUL 1 0 1986

Department of Natural Resources
Bureau of Land & Water Resources

If well telescopes please sketch and show depths.

GROUND LEVEL

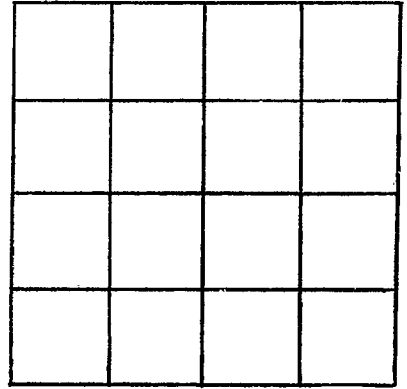

SECTION _____

Please indicate well location X.

ADDITIONAL INFORMATION

If more than one screen, show locations of each on sketch.