

MISSISSIPPI DEPARTMENT OF NATURAL RESOURCES

Bureau of Land and Water Resources

Southport Mall

P.O. Box 10631

Jackson, Mississippi 39209

CODED

WATER WELL DRILLERS LOG

Griner Drilling Service, Inc.

pearl RIVER

Pearl River
K 66
7-2-86

7-2-86 date well completed

Griner Drilling Service, Inc. firm name

pearl RIVER county well located

LANDOWNER:

EXXON CO., U.S.A.
P.O. Box 60006
New Orleans, La. 70160
(mailing address)

description of formations encountered

from

to

Top soil

0 10

SAND

10 30

CLAY

30 105

SAND

105 147

CLAY

CODED

147 250

SAND

250 315

CLAY

315 336

WELL LOCATION:

1506' S 41700' W of
sec 13 T 3 N R 11 E NE KOR
No. 1 Koch Pearlville Field
1.5 miles (distance) of (direction) or (nearest town)

WELL PURPOSE:

Oilfield rig
(home, irrigation, municipal, industrial)

WELL COMPLETION DATA:

- (1) diameter (inches) 4"
- (2) total depth (feet) 336'
- (3) static water level (feet) 15' ^{below} top of ground.

- (4) casing steel 315' (material) (depth)
4" (size) If telescope see back.

- (5) screen 20' 295' (length) (depth to top)
4" stainless steel (size) (material)

- (6) pump 5 100 (HP) (yield gpm)
230 volt 3 phase (type power)

- (7) electric log (yes or no)

(organization running log)

- (8) how well bottom plugged Orange peel

DRILLERS REMARKS:

Water Well No. 2


RECEIVED

OCT 17 1986

Department of Natural Resources
Bureau of Land & Water Resources

If well telescopes please sketch and show depths.

GROUND LEVEL

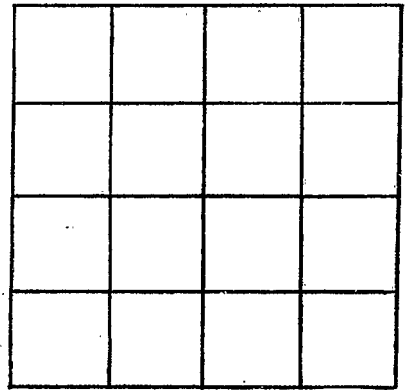

SECTION _____

Please indicate well location X.

ADDITIONAL INFORMATION

If more than one screen,
show locations of each on sketch.