

MISSISSIPPI DEPARTMENT OF NATURAL RESOURCES
 Bureau of Land and Water Resources
 Southport Mall
 P.O. Box 10631
 Jackson, Mississippi 39209
WATER WELL DRILLERS LOG

Pearl River
~~W 274~~
K67

8/19 1986 BUD DENTON PEARL RIVER
 date well completed firm name county well located

LANDOWNER: CAL LIOTTE

High 26
POPLARVILLE MISS.
 (mailing address)

WELL LOCATION:
 sec. 17 T. 3 N. R. 17 E.
8 miles West of Poplarville
 (distance) (direction) (nearest town)

WELL PURPOSE: FARM
 (home, irrigation, municipal, industrial)

WELL COMPLETION DATA:

- (1) diameter (inches) 6' 4"
- (2) total depth (feet) 1156
- (3) static water level (feet) 89 below above-top of ground.
- (4) casing Steel, 1156,
 (material) (depth)
 (size) if telescope see back.
- (5) screen 30, 12,
 (length) (depth to top)
12, Steel
 (size) (material)
- (6) pump 1.5, 235
 (HP) (yield gpm)
 (type power)
- (7) electric log no
 (yes or no)
 (organization running log)
- (8) how well bottom plugged hard

description of formations encountered	from	to
Red shale	0	20
Red sand	60	90
Blue shale	90	175
White sand	175	250
Blue shale	250	375
Gray sand	375	650
Blue shale	650	1156
Gray sand	1075	1156

RECEIVED


APR 21 1987

Department of Natural Resources
 Bureau of Land & Water Resources

DRILLERS REMARKS: The well was cemented 60 ft

If well telescopes please sketch and show depths.

GROUND LEVEL

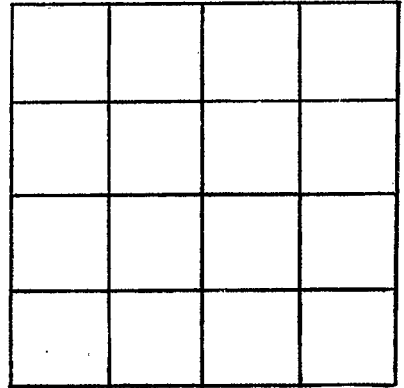

SECTION _____

Please indicate well location X.

ADDITIONAL INFORMATION

If more than one screen, show locations of each on sketch.