

Part 2 never received 4/13

State Well Report Part 1 - Driller's Log

Mississippi Department of Environmental Quality
Office of Land and Water Resources
P.O. Box 2309
Jackson, MS 39225
(601)961-5210
(601)961-5228 (fax)

County: Pearl River
 Permit #: _____
 Driller: Teme Singleton
 Date drilling completed: 5/19/09

For Office Use Only:
 Aquifer: _____
 Well #: K 88
 L. S. Elevation: _____
 E-log #: _____

State Law requires that this report be prepared by the license holder responsible for the work and filed with the Department at the above address within 30 days of completion of drilling of the well or borehole.

<p align="center">Information on Well Owner <i>(Landowner if borehole is not for a water well)</i></p> <p>Owner Name: <u>Dominick Addotto</u> Mailing Address: <u>329 Buck Stuart Rd</u> <u>Poplaville, MS 39470</u> <small>City State Zip Code</small> Telephone No. <u>(601) 795-9870</u></p>	<p align="center">Well or Borehole Location</p> <p>Latitude: <u>30° 48' 56"</u> Longitude: <u>89° 43' 15"</u> Method of Lat/Long (circle one): <u>Google Earth</u> Conventional Survey, USGS quad, Hand-held GPS, Survey-grade GPS <u>NW ¼ SE ¼ Sec 5 Twn 35 Rng 17W</u> Distance Direction Nearest Town <u>6 Miles E-N/E of Crossroads</u></p>
--	---

Well / Borehole Data

Date drilling started: 5/19/09 Date drilling completed: 5/19/09 Hole depth: 90' Hole diameter: 6 3/4"
 Location of the source of any surface water used for drilling: Private well (Singleton's)
 Method of dosing and volume of Chlorine used in drilling and development: 1 gallon Bleach / 1000 gallons
 Logs run (circle all applicable): No log run Electric Gamma Ray Density Sonic Neutron Other: _____
 Name of organization running log(s): N/A
 Purpose of borehole (check one): Water Well Geotechnical/Geological Investigation _____ Ground Source Heat Pump _____
 Seismic Survey _____ Other (describe) _____
If drilling is not related to water well construction, skip the remainder of this block


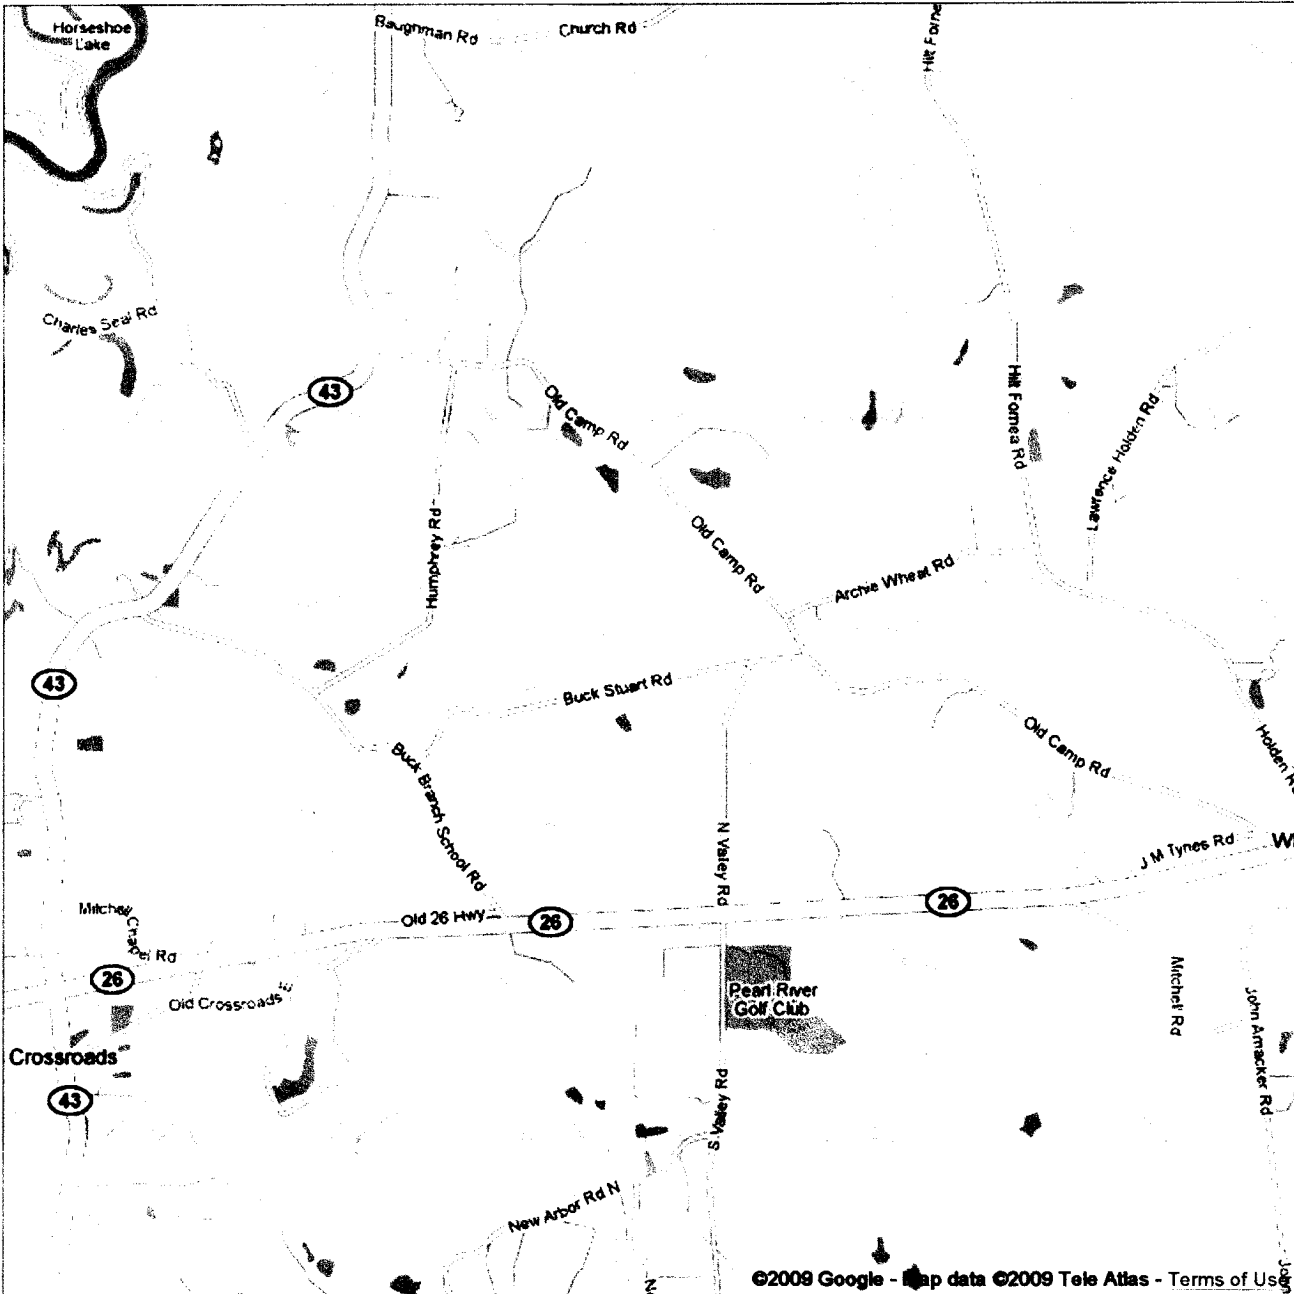
Purpose of Well (check one): Home _____ Industrial _____ Public Supply _____ Irrigation Fish Culture _____ Other: _____
 If a flowing well, method of flow regulation: Valve N/A Other (describe) N/A
 Static Water Level: 45' feet above of below (circle one) land surface Date measured: 5/19/09
 Method of Measurement (circle one): steel tape electric tape air line other: _____
 Well depth: 90 Well grouted to a depth of 10 feet Type of grout (circle one): Neat Cement Bentonite Mix
 Casing length: 70 feet Casing diameter: 4 inches Type of casing: PVC schd 40
 Screen length: 20 feet Screen diameter: 4 inches Type of screen: PVC slotted
 Screen slot size: .014 inches Setting depth: From 70 feet to 90 feet
 Type of completion (circle all applicable): Gravel packed Underreamed Telescoped Open hole Natural Development
 Other (describe): _____
 Top of lap pipe or reduction in casing: N/A feet. *If telescoped or more than one screen, describe on next page*

Form: OLWR-SWR-1A (04/08)

RECEIVED
JUN 15 2009
BY: OLWR

Google maps

Get Google Maps on your phone
Text the word "GMAPS" to 466453

RECEIVED
JUN 15 2009
BY: OLWR