

Pearl River  
K 2000  
11-11-75

MISSISSIPPI  
 BOARD OF WATER COMMISSIONERS  
 416 North State Street  
 Jackson, Mississippi 39201

WATER WELL DRILLERS LOG

13V

Nov. 11 1975  
 date well completed

Stafford Wells  
 firm name

Pearl River County  
 county well located

LANDOWNER:

Heart Lung

(mailing address)

WELL LOCATION:

sec. 2 T 3 N R 17 E  
6 miles East of Pennington  
 (distance) (direction) (nearest town)

WELL PURPOSE: Home  
 (home, irrigation, municipal, industrial)

WELL COMPLETION DATA:

- (1) diameter (inches) 4"
- (2) total depth (feet) 205 ft
- (3) static water level (feet) 190 below above top of ground.
- (4) casing plastic, 195'  
 (material) (depth)  
4" if telescope see back.  
 (size)
- (5) screen 12 ft, 195 ft  
 (length) (depth to top)  
4" plastic  
 (size) (material)
- (6) pump 100 20  
 (HP) (yield gpm)  
Elect.  
 (type power)
- (7) electric log \_\_\_\_\_  
 (yes or no)
- (organization running log) \_\_\_\_\_
- (8) how well bottom plugged B.W.O.


description of formations encountered

from to

<u>top soil</u>	<u>0</u>	<u>3</u>
<u>clay</u>	<u>3</u>	<u>10</u>
<u>chalk</u>	<u>10</u>	<u>140</u>
<u>sand</u>	<u>140</u>	<u>155</u>
<u>chalk</u>	<u>155</u>	<u>190</u>
<u>sand</u>	<u>190</u>	<u>205</u>

DRILLERS REMARKS:

Salmagly Dykes

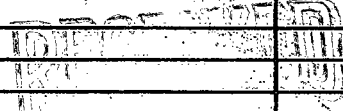


DEC 1 1975

MISS. BD. OF WATER COMMISSIONERS

If well telescopes please sketch and show depths.

GROUND LEVEL

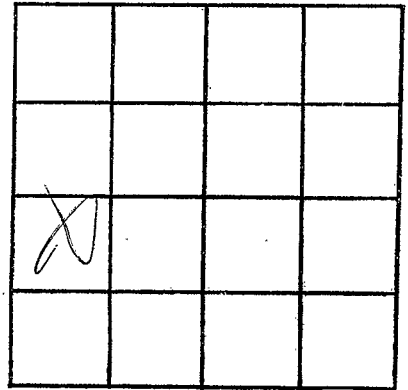

SECTION \_\_\_\_\_

Please indicate well location X.

ADDITIONAL INFORMATION

If more than one screen,  
show locations of each on sketch.