

Pearl River
K 2001
11-12-75

MISSISSIPPI
 BOARD OF WATER COMMISSIONERS
 416 North State Street
 Jackson, Mississippi 39201

WATER WELL DRILLERS LOG


11/12/1975 date well completed Staffed Well Ser. firm name Pearl River County county well located

LANDOWNER:	description of formations encountered	from	to
<u>Joseph J. Swings</u>			
(mailing address)	<u>chalk</u>	<u>5</u>	<u>40</u>
WELL LOCATION:	<u>sand</u>	<u>40</u>	<u>150</u>
sec. <u>2</u> T. <u>3</u> N. R. <u>17</u> E.			
<u>6</u> miles <u>E</u> of <u>Romwood</u>			
(distance) (direction) (nearest town)			
WELL PURPOSE: <u>Home</u>			
(home, irrigation, municipal, industrial)			
WELL COMPLETION DATA:			
(1) diameter (inches) <u>4"</u>			
(2) total depth (feet) <u>150 ft</u>			
(3) static water level (feet) <u>130</u> below above top of ground.			
(4) casing <u>plastic</u> <u>140</u>			
(material) (depth)			
<u>4"</u> If telescope see back.			
(size)			
(5) screen <u>10 ft</u> <u>140 ft</u>			
(length) (depth to top)			
<u>4"</u> <u>plastic</u>			
(size) (material)			
(6) pump <u>1/2</u> <u>10</u>			
(HP) (yield gpm)			
<u>Elect.</u>			
(type power)			
(7) electric log _____			
(yes or no)			
(organization running log)			
(8) how well bottom plugged <u>B.W.O.</u>			
DRILLERS REMARKS:			
<u>Damage Dyer</u>			

DEC 11 1975
 MISS. RD. DEPT. OF WATER CONTROL

If well telescopes please sketch and show depths.

GROUND LEVEL

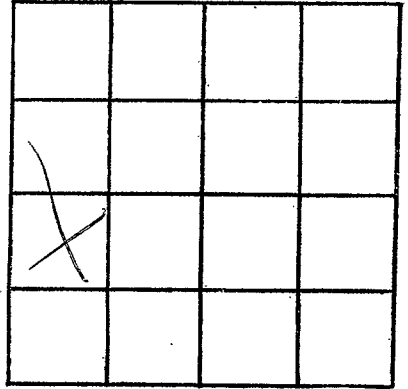

SECTION _____

Please indicate well location X.

ADDITIONAL INFORMATION

If more than one screen,
show locations of each on sketch.