

Pearl River
K 2003
3-31-76

MISSISSIPPI
 BOARD OF WATER COMMISSIONERS
 416 North State Street
 Jackson, Mississippi 39201

WATER WELL DRILLERS LOG

3-31-
 date well completed

13 ✓ 26 Leimpein Well Co.
 firm name

Pearl River
 county well located

LANDOWNER:
Mr. Fred Lee
Paplarville, Mo.
 (mailing address)

description of formations encountered	from	to
Clay	0	60
Sand	60	120
Clay	120	140
Sand	140	160

WELL LOCATION:
 sec 16 T 3 N 17 E
6 miles W of Paplarville
 (distance) (direction) (nearest town)

WELL PURPOSE:
 (home, irrigation, municipal, industrial)


- WELL COMPLETION DATA:
- (1) diameter (inches) 2"
 - (2) total depth (feet) 166'
 - (3) static water level (feet) 40' below above top of ground.
 - (4) casing P.V.C. 160'
 (material) (depth)
2" if telescope see back.
 (size)
 - (5) screen 6' 160'
 (length) (depth to top)
2" P.V.C.
 (size) (material)
 - (6) pump 1/2 275
 (HP) (yield gpm)
Elec.
 (type power)
 - (7) electric log No
 (yes or no)
- (organization running log)
- (8) how well bottom plugged Sand Shale

DRILLERS REMARKS:

JUN 21 1976
 MISSISSIPPI BOARD OF WATER COMMISSIONERS

If well telescopes please sketch and show depths.

GROUND LEVEL

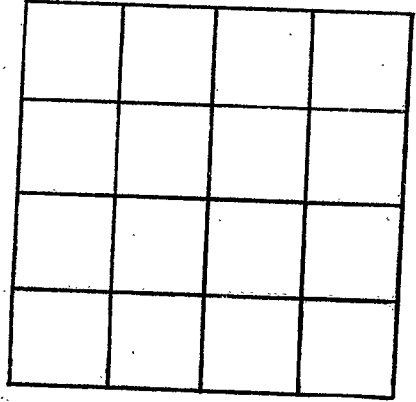

SECTION _____

Please indicate well location X.

ADDITIONAL INFORMATION

If more than one screen, show locations of each on sketch.