

*Col*

Pearl River  
K 2004  
July 12, 1976

MISSISSIPPI  
BOARD OF WATER COMMISSIONERS  
416 North State Street  
Jackson, Mississippi 39201

WATER WELL DRILLERS LOG

July 12 1976 R. Woodward Drilling Pearl River  
date well completed firm name county well located


LANDOWNER: Ellie E. Spier  
Rt. 1 Poplarville, Miss.  
  
(mailing address)

WELL LOCATION:  
sec. 18 T. 3 S. R. 18 W.  
2 1/2 miles (distance) West (direction) of Roseville (nearest town)

WELL PURPOSE: Home  
(home, irrigation, municipal, industrial)

- WELL COMPLETION DATA:
- (1) diameter (inches) 4"
  - (2) total depth (feet) 130'
  - (3) static water level (feet) 80' below top of ground.
  - (4) casing (material) PVC (depth) 120', (size) 4" If telescope see back.
  - (5) screen (length) 10' (depth to top) 120', (size) 4" X .015 (material) PVC
  - (6) pump (HP) 1 (yield gpm) 15, (type power) 230V AC
  - (7) electric log NO (yes or no)  
  
(organization running log)
  - (8) how well bottom plugged float  
Type B. W. V.


description of formations encountered	from	to
<u>Red sandy clay</u>	<u>0</u>	<u>23'</u>
<u>Red sand</u>	<u>23</u>	<u>46'</u>
<u>Pink Clay</u>	<u>46</u>	<u>85'</u>
<u>Fine sand</u>	<u>85</u>	<u>115'</u>
<u>good sand</u>	<u>115</u>	<u>130'</u>

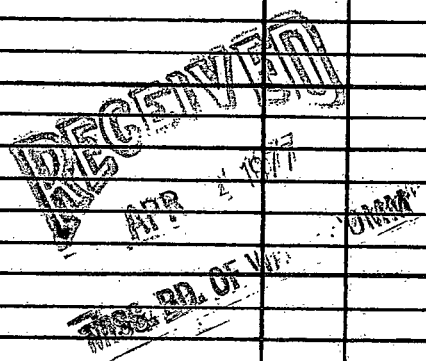

DRILLERS REMARKS:

If well telescopes please sketch and show depths.

GROUND LEVEL

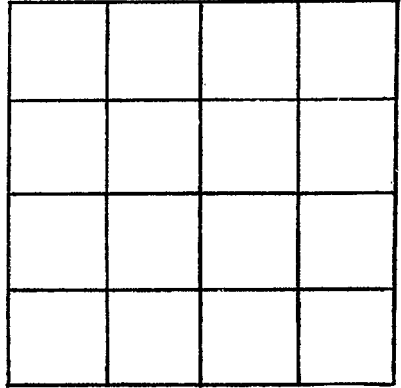

SECTION \_\_\_\_\_

Please indicate well location X.

ADDITIONAL INFORMATION

If more than one screen,  
show locations of each on sketch.