

Pearl River
 K 2006
 6-1-77

MISSISSIPPI
 BOARD OF WATER COMMISSIONERS
 416 North State Street
 Jackson, Mississippi 39201

WATER WELL DRILLERS LOG

6/1 1977 Bud Penton & Son Pearl River
 date well completed firm name county well located

LANDOWNER: Phillips
Wormes
B.T. 3 Poplarville
 (mailing address)

description of formations encountered	from	to
	<u>Red Shale</u>	<u>0</u>
<u>White sand</u>	<u>78</u>	<u>120</u>

WELL LOCATION:
 sec 26 T 3 N R 17 E
12 7/8 miles S of Poplarville
 (distance) (direction) (nearest town)

WELL PURPOSE: home
 (home, irrigation, municipal, industrial)

WELL COMPLETION DATA:

- (1) diameter (inches) 2"
- (2) total depth (feet) 120
- (3) static water level (feet) 35 1/2 below top of ground.
- (4) casing pvc 1 1/2"
 (material) (depth)
- (5) screen 5 1/2" 1 1/2"
 (length) (depth to top)
- (6) pump 1 1/2 750
 (HP) (yield gpm)
- (7) electric log no
 (yes or no)

(organization running log)

(8) how well bottom plugged hard


DRILLERS REMARKS:

RECEIVED

SEP 13 1977

If well telescopes please sketch and show depths.

GROUND LEVEL

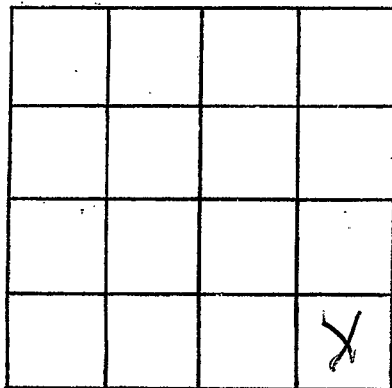

SECTION _____

Please indicate well location X.

ADDITIONAL INFORMATION

If more than one screen,
show locations of each on sketch.