

Pearl River
R 2007
8-13-77

MISSISSIPPI
 BOARD OF WATER COMMISSIONERS
 416 North State Street
 13V Jackson, Mississippi 39201

WATER WELL DRILLERS LOG

STOCKSTILL BROS., INC. Pearl River
 firm name county well located

8-13 1977
 date well completed

LANDOWNER:
Mr. Bill Maltman
Pt. 3 Poplarville, Miss.
 (mailing address)

description of formations encountered	from	to
Clay	0	30
Sand	30	120
Clay	120	210
Sand	210	276

WELL LOCATION:
 sec 28 T S N R 17 E W
6 1/2 miles W of Derby
 (distance) (direction) (nearest town)

WELL PURPOSE: Home
 (home, irrigation, municipal, industrial)

- WELL COMPLETION DATA:
- (1) diameter (inches) 4"
 - (2) total depth (feet) 276'
 - (3) static water level (feet) 110 below above top of ground.
 - (4) casing P.V.C. 266'
 (material) (depth)
4"
 (size) if telescope see back.
 - (5) screen 10' 266'
 (length) (depth to top)
4" P.V.C.
 (size) (material)
 - (6) pump 1 28
 (HP) (yield gpm)
Elec.
 (type power)
 - (7) electric log No
 (yes or no)
No
 (organization running log)
 - (8) how well bottom plugged Sand Shale


RECEIVED
 SEP 22 1977

MISS. DIV. OF WATER CONTROL

DRILLERS REMARKS:

If well telescopes please sketch and show depths.

GROUND LEVEL

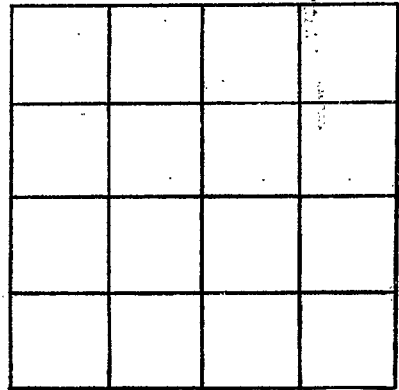

SECTION _____

Please indicate well location X.

ADDITIONAL INFORMATION

If more than one screen, show locations of each on sketch.