

PEARL RIVER

2009 K

MISSISSIPPI BOARD OF WATER COMMISSIONERS
416 North State Street
Jackson, Mississippi 39201

WATER WELL DRILLERS LOG

7-21
date well completed

1978 Bud Ruten & Son
firm name

Pearl River
county well located

LANDOWNER:
Hunter Balin
Poplarville, Ms.
(mailing address)

description of formations encountered	from	to
White Shale	0	26
White Sand	26	110
Blue Shale	110	120
Red Sand	120	216
Blue Shale	216	295
Grey Sand	295	390
Blue Shale	390	450
Grey Sand	450	481


WELL LOCATION:
sec. 24 T 3 N R 17 E
S
14 miles S-W of Poplarville
(distance) (direction) (nearest town)

WELL PURPOSE:
(home, irrigation, municipal, industrial)

- WELL COMPLETION DATA:
- (1) diameter (inches) 2 1/2
 - (2) total depth (feet) 481
 - (3) static water level (feet) 8 below top of ground.
 - (4) casing Galv. 481 (material) (depth)
 - (5) screen 2 x 10 471 (length) (depth to top)
12 S. Steel (size) (material)
 - (6) pump 3/4 450 (HP) (yield gpm)
electric (type power)
 - (7) electric log NO (yes or no)

(organization running log)
(8) how well bottom plugged Sand Shale


DRILLERS REMARKS:

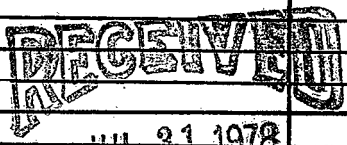

MISS. BD. OF WATER COMMISSIONERS

If well telescopes please sketch and show depths.

GROUND LEVEL

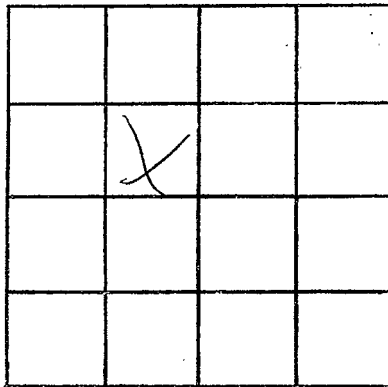

SECTION _____

Please indicate well location X.

ADDITIONAL INFORMATION

If more than one screen, show locations of each on sketch.