

PEARL RIVER
K 2010

MISSISSIPPI
BOARD OF WATER COMMISSIONERS
416 North State Street
Jackson, Mississippi 39201

WATER WELL DRILLERS LOG

6-9 1978 Bud Penton & Son Pearl River
date well completed firm name county well located

LANDOWNER:
Miss Tylee & Soap Co.
Poplarville, Ms.
(mailing address)

description of formations encountered	from	to
Red Shale	0	18
Blue Shale	18	300
Grey sand	300	324

WELL LOCATION:
sec. 26 T 30 N R 17 E
S W of Poplarville
(distance) (direction) (nearest town)

WELL PURPOSE:
(home, irrigation, municipal, industrial)

WELL COMPLETION DATA:

(1) diameter (inches) 4 in

(2) total depth (feet) 324

(3) static water level (feet) ~~126~~ below top of ground.

(4) casing PVC, 324.
(material) (depth)

(size) if telescope see back.

(5) screen 4x10, 314
(length) (depth to top)

12 PVC
(size) (material)

(6) pump 1 650
(HP) (yield gpm)

electric
(type power)

(7) electric log NO
(yes or no)

(organization running log)

(8) how well bottom plugged
Sand Shank


DRILLERS REMARKS:

RECEIVED
JUL 31 1978

MISS. BD. OF WATER COMMISSIONERS

If well telescopes please sketch and show depths.

GROUND LEVEL

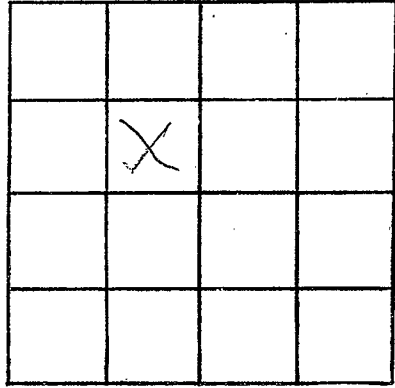

SECTION _____

Please indicate well location X.

ADDITIONAL INFORMATION

If more than one screen,
show locations of each on sketch.