

PEARL RIVER
K 2011

MISSISSIPPI
BOARD OF WATER COMMISSIONERS
416 North State Street
Jackson, Mississippi 39201

WATER WELL DRILLERS LOG

5-17-78 date well completed Bud Denton firm name Pearl River county well located

LANDOWNER:
Frank Smith
Poplarville, Miss.
(mailing address)

description of formations encountered	from	to
Red shale	0	30
sand	30	133

WELL LOCATION:
sec. 25 T 3 N R 17 E
4 miles W of Osley
(distance) (direction) (nearest town)

WELL PURPOSE: Home
(home, irrigation, municipal, industrial)

- WELL COMPLETION DATA:
- (1) diameter (inches) 4 in
 - (2) total depth (feet) 133
 - (3) static water level (feet) 27 below top of ground.
 - (4) casing PVC 133
(material) (depth)
 - (size) if telescope see back.
 - (5) screen 4x10 123
(length) (depth to top)
12 PVC
(size) (material)
 - (6) pump 1/2 800
(HP) (yield gpm)
electric
(type power)
 - (7) electric log NO
(yes or no)
- (organization running log)

(8) how well bottom plugged
sand shark


DRILLERS REMARKS:

RECEIVED
JUL 31 1978

MISS. Bd. of WATER COMMISSIONERS

If well telescopes please sketch and show depths.

GROUND LEVEL

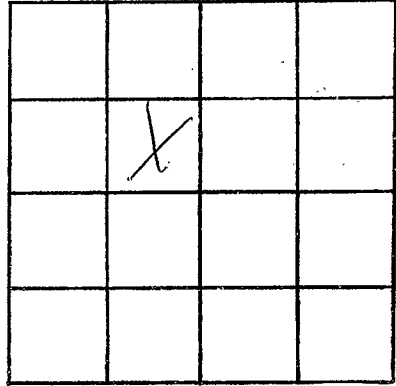

SECTION _____

Please indicate well location X.

ADDITIONAL INFORMATION

If more than one screen,
show locations of each on sketch.