

PEARL RIVER
 K 2012
 9-12-78

MISSISSIPPI
 BOARD OF WATER COMMISSIONERS
 416 North State Street
 Jackson, Mississippi 39201

WATER WELL DRILLERS LOG

Sept. 12, 1978 date well completed
 Dixie Water Well & Pump, Inc. firm name
 Pearl River county well located

LANDOWNER: Tommy Anacker
 Route 3 Box
 Poplarville, Miss. 39470
 (mailing address)

description of formations encountered	from	to
Red Sandy Clay	0	17'
White Coarse Sand	17'	92'

WELL LOCATION:
 sec. 24 T 3 N R 17 E
 2 miles South of White Sands
 (distance) (direction) (nearest town)

WELL PURPOSE: Home
 (home, irrigation, municipal, industrial)

WELL COMPLETION DATA:

(1) diameter (inches) 4"

(2) total depth (feet) 92'

(3) static water level (feet) 22' below top of ground.

(4) casing P.V.C. 82' (material) (depth)
 4" (size) If telescope see back.

(5) screen 10' 92' (length) (depth to top)
 4" (size) P.V.C. (material)

(6) pump 1/2 (HP) 8 (yield gpm)
 Electric (type power)

(7) electric log No (yes or no)

(organization running log)

(8) how well bottom plugged Sand Shark


RECEIVED
 OCT 6 1978

MISS. BD. OF WATER COMM.

DRILLERS REMARKS:

If well telescopes please sketch and show depths.

GROUND LEVEL

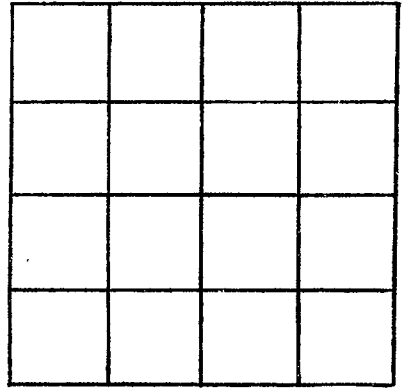

SECTION _____

Please indicate well location X.

ADDITIONAL INFORMATION

If more than one screen,
show locations of each on sketch.