

PEARL RIVER
K 0013
8-17-78

MISSISSIPPI
BOARD OF WATER COMMISSIONERS
416 North State Street
Jackson, Mississippi 39201

WATER WELL DRILLERS LOG

8/77 1978 *Paul Perkinson* Pearl River
date well completed firm name county well located

LANDOWNER: *Ms. Edith [unclear]*
Poplarville Miss.
(mailing address)

description of formations encountered	from	to
<i>Red Shale</i>	<i>0</i>	<i>65</i>
<i>Gray Shale</i>	<i>65</i>	<i>325</i>
<i>Gray Sand</i>	<i>325</i>	<i>363</i>

WELL LOCATION:
sec. *16* T. *3* N R. *17* E
12 miles (distance) *W* (direction) of *Poplarville* (nearest town)

WELL PURPOSE: *Home*
(home, irrigation, municipal, industrial)

WELL COMPLETION DATA:

(1) diameter (inches) *2*"

(2) total depth (feet) *363*

(3) static water level (feet) *44* below above top of ground

(4) casing *galv.* (material), *353* (depth)
no (size) if telescope see back.

(5) screen *2x10* (length), *353* (depth to top)
12 (size), *stl steel* (material)


(6) pump *1* (HP), *560* (yield gpm)
Elect (type power)

(7) electric log *no* (yes or no)

(organization running log)


(8) how well bottom plugged *sharp*

DRILLERS REMARKS:

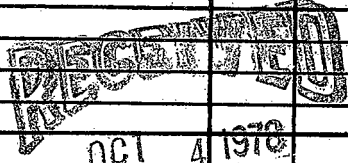

If well telescopes please sketch and show depths.

GROUND LEVEL

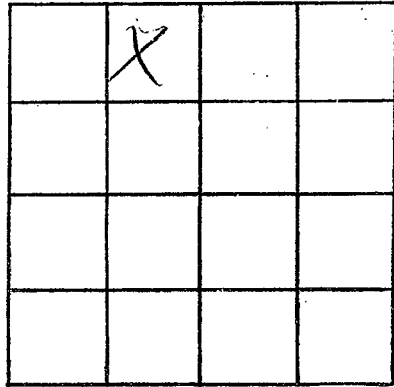

SECTION _____

Please indicate well location X.

ADDITIONAL INFORMATION

If more than one screen,
show locations of each on sketch.