

Pearl River
K 2014
8-24-81

MISSISSIPPI
BOARD OF WATER COMMISSIONERS
416 North State Street
Jackson, Mississippi 39201

WATER WELL DRILLERS LOG

8-24-81 date well completed
Hoffman Well firm name
Pearl River county well located

LANDOWNER: Otto LeMaire

description of formations encountered

from to

Pearl River, Miss
(mailing address)

top soil	0	2
sand clay	2	40
white chalk	40	90
gravel	90	120
sand & gravel	120	134


WELL LOCATION:

sec. 3 T. 3 N. R. 17 E
4 miles NE of Crossroads
(distance) (direction) (nearest town)

WELL PURPOSE: Home
(home, irrigation, municipal, industrial)

WELL COMPLETION DATA:

- (1) diameter (inches) 4"
- (2) total depth (feet) 134
- (3) static water level (feet) 100 below top of ground
- (4) casing plastic 124' (material) (depth)
4" (size) If telescope see back.
- (5) screen 104' 124' (length) (depth to top)
4" (size) plastic (material)
- (6) pump 1/2 HP (HP) (yield gpm)
Elect. (type power)
- (7) electric log (yes or no)
- (8) how well bottom plugged BWW

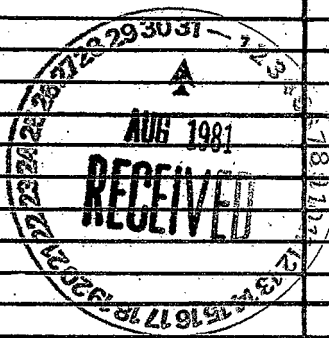


DRILLERS REMARKS:

[Handwritten signature]

If well telescopes please
sketch and show depths.

GROUND LEVEL

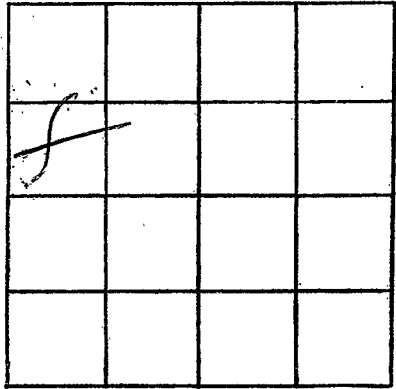

SECTION _____

Please indicate well location X.

ADDITIONAL INFORMATION

If more than one screen,
show locations of each on sketch.