

MISSISSIPPI DEPARTMENT OF NATURAL RESOURCES

Bureau of Land and Water Resources

Southport Mall

P.O. Box 10631

Jackson, Mississippi 39209

WATER WELL DRILLERS LOG

PEARL RIVER
K 2015
10-29-81

Walker Welding & Repair Shop

Beard River

Oct 29 1981  
date well completed

firm name

county well located

LANDOWNER: <u>Alberta Holden</u> <u>RT.</u>	description of formations encountered	from	to
		<u>Red sand</u>	<u>1</u> <u>30'</u>
		<u>Coarse sand</u>	<u>30</u> <u>65'</u>
Poplarville Miss. (mailing address)	<u>Gravel</u>	<u>65</u>	<u>68'</u>

WELL LOCATION:  
 sec. 1 T. 3 S. R. 17 E. W.  
8 miles W of Poplarville  
 (distance) (direction) (nearest town)

WELL PURPOSE: Home  
 (home, irrigation, municipal, industrial)

- WELL COMPLETION DATA:
- (1) diameter (inches) 2"
  - (2) total depth (feet) 68'
  - (3) static water level (feet) 25 below top of ground.
  - (4) casing PVC, 68'  
 (material) (depth)
  - 1 1/2" if telescope see back.  
 (size)
  - (5) screen 10', 58'  
 (length) (depth to top)
  - 12, PVC  
 (size) (material)
  - (6) pump 1/2, 7 1/2 Gall Min.  
 (HP) (yield gpm)
  - Electric  
 (type power)
  - (7) electric log                       
 (yes or no)
  - (organization running log) Sound Check
  - (8) how well bottom plugged

DEPT. OF NATURAL RESOURCES  
 BUREAU OF LAND & WATER RESOURCES


NOV 10 1981

RECEIVED

DRILLERS REMARKS:  
 \_\_\_\_\_  
 \_\_\_\_\_  
 \_\_\_\_\_

If well telescopes please sketch and show depths.

GROUND LEVEL

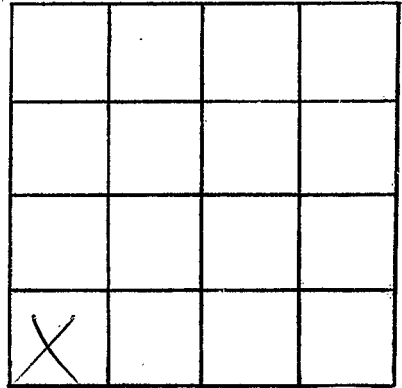

SECTION \_\_\_\_\_

Please indicate well location X.

ADDITIONAL INFORMATION

RECEIVED  
NOV 10  
A B : 47

If more than one screen, show locations of each on sketch.