

MISSISSIPPI DEPARTMENT OF NATURAL RESOURCES

Bureau of Land and Water Resources

Southport Mall

P.O. Box 10631

Jackson, Mississippi 39209

WATER WELL DRILLERS LOG

Pearl River
K 2016

Oct 15 1982
date well completed

822 Walker Valley
firm name


Pearl River
county well located

LANDOWNER: <u>W E Tomburn</u>	description of formations encountered	from	to
<u>RT 2 Poplar Marine</u> (mailing address)	<u>Red shale</u> <u>Grey shale</u> <u>Sand</u>	<u>0</u> <u>16</u> <u>74</u>	<u>16</u> <u>74</u> <u>110</u>
WELL LOCATION: sec <u>20</u> T <u>3</u> N R <u>17</u> A S W <u>15</u> miles <u>W</u> <u>Poplarville</u> (distance) (direction) (nearest town)			
WELL PURPOSE: <u>home</u> (home, irrigation, municipal, industrial)			
WELL COMPLETION DATA:			
(1) diameter (inches) <u>2"</u>			
(2) total depth (feet) <u>110'</u>			
(3) static water level (feet) <u>68</u> below above top of ground.			
(4) casing <u>PVC</u> <u>100</u> (material) (depth)			
_____ (size) if telescope see back.			
(5) screen <u>10"</u> <u>100'</u> (length) (depth to top)			
<u>15 S</u> <u>PVC</u> (size) (material)			
(6) pump <u>1.44P</u> <u>7</u> (HP) (yield gpm)			
<u>Elec</u> (type power)			
(7) electric log _____ (yes or no)			
_____ (organization running log)			
(8) how well bottom plugged <u>Sand</u> <u>shank</u>			
DRILLERS REMARKS:			

DEPT. OF NATURAL RESOURCES
BUREAU OF LAND & WATER RESOURCES
NOV - 1 1982
RECEIVED

If well telescopes please sketch and show depths.

GROUND LEVEL

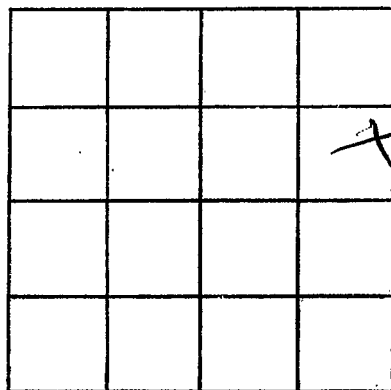

SECTION _____

Please indicate well location X.

ADDITIONAL INFORMATION

If more than one screen,
show locations of each on sketch.