

MISSISSIPPI DEPARTMENT OF NATURAL RESOURCES

Bureau of Land and Water Resources
 WATER WELL SERVICE
 ROUTE 4 BOX 402 Southport Mall
 CARRIERE, MS 39223 P.O. Box 10631
 PHONE 782-5324 Jackson, Mississippi 39209

Pearl River
K 2018
K

WATER WELL DRILLERS LOG

BUD PENTON & SON
 WATER WELL SERVICE
 ROUTE 4 BOX 402
 CARRIERE, MISSISSIPPI 39223
 PHONE 782-5324

10/18 19
 date well completed

Pearl River
 county well located

LANDOWNER: <u>Mr Don Chance</u>	description of formations encountered	from	to
<u>P.O. Box Pearl River, Miss</u> (mailing address)			
	<u>blue shale</u>	<u>12</u>	<u>250</u>
	<u>gray sand</u>	<u>250</u>	<u>310</u>

WELL LOCATION:
 sec. 10 - T 3 N S R 17 E W
5 miles (distance) W (direction) of Pearl River (nearest town)

WELL PURPOSE: home
 (home, irrigation, municipal, industrial)


- WELL COMPLETION DATA:
- (1) diameter (inches) 4"
 - (2) total depth (feet) 310
 - (3) static water level (feet) 93 below above top of ground.
 - (4) casing PVC, 310 (material) (depth)
 (size) if telescope see back.
 - (5) screen 44.5", 30.5" (length) (depth to top)
12 (size), PVC (material)
 - (6) pump 1/2 (HP), 600 (yield gpm)
Elect (type power)
 - (7) electric log no (yes or no)

(organization running log)
 (8) how well bottom plugged hard
short

DRILLERS REMARKS:

If well telescopes please sketch and show depths.

GROUND LEVEL

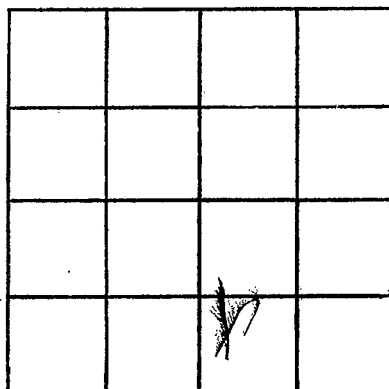

SECTION _____

Please indicate well location X.

ADDITIONAL INFORMATION

DEPT. OF NATURAL RESOURCES
BUREAU OF LAND & WATER RESOURCES

NOV 18 1983

RECEIVED

If more than one screen, show locations of each on sketch.