

MISSISSIPPI DEPARTMENT OF NATURAL RESOURCES

Bureau of Land and Water Resources

Southport Mall

P.O. Box 10631

Jackson, Mississippi 39209

WATER WELL DRILLERS LOG

Pearl River
R 209

7 10 1983
date well completed

Jimmy L. Small Pearl River
firm name county well located

LANDOWNER: J. D. HUMPHREY
Rant 1
Paplaunt Miss
(mailing address)

description of formations encountered	from	to
TOP SOIL	0	2
RED CLAY	2	60
RED SAND	60	70
CLAY ANDED	70	100
SILT SANDY ST.	100	125
SAND FINE	100	122

WELL LOCATION:
sec. 1 T 3 S R 17 W
6 NORTH EAST of CROSSROADS
(distance) (direction) (nearest town)

WELL PURPOSE: HOME
(home, irrigation, municipal, industrial)

WELL COMPLETION DATA: 7-8-83

- (1) diameter (inches) 4"
- (2) total depth (feet) 122'
- (3) static water level (feet) 80' below top of ground.
- (4) casing PVC, 100' (material) (depth)
if telescope see back.
- (5) screen 90 (length) (depth to top)
4 (size) PVC (material)
- (6) pump 1/2 (HP) 19 (yield gpm)
Electrical (type power)
- (7) electric log yes or no
(organization running log)
- (8) how well bottom plugged SAND SHARK
STEEL

DEPT. OF NATURAL RESOURCES
BUREAU OF LAND & WATER RESOURCES


FEB 23 1984

RECEIVED

DRILLERS REMARKS:

If well telescopes please sketch and show depths.

GROUND LEVEL

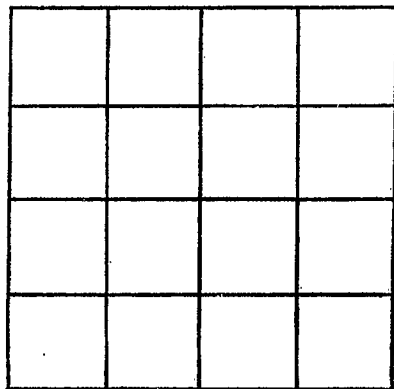

SECTION _____

Please indicate well location X.

ADDITIONAL INFORMATION

If more than one screen, show locations of each on sketch.