

MISSISSIPPI DEPARTMENT OF NATURAL RESOURCES

Bureau of Land and Water Resources

Southport Mall

P.O. Box 10631

Jackson, Mississippi 39209

BUD PEY WATER WELL DRILLERS LOG

WATER WELL SERVICE

ROUTE BOX

PHONE 111-1111

Pearl River
K 0021

6/15
date well completed

1984

Pearl River
county well located

LANDOWNER: Lorie Watkins

description of formations encountered

from

to

A.T. 1 Carriere

Red shale
white sand

0 75-
75/28

ms.

(mailing address)

WELL LOCATION:

sec. 26 T 3 N R 17 E
S W

8 miles N of McNeal
(distance) (direction) (nearest town)

WELL PURPOSE:

home
(home, irrigation, municipal, industrial)

WELL COMPLETION DATA:

- (1) diameter (inches) 4"
(2) total depth (feet) 128
(3) static water level (feet) 20 below
top of ground. above

- (4) casing PVC, 128,
(material) (depth)

(size) if telescope see back.

- (5) screen 10, 118
(length) (depth to top)

12, PVC
(size) (material)

- (6) pump 2, 1760
(HP) (yield gpm)

Elect
(type power)

- (7) electric log no
(yes or no)

(organization running log)

- (8) how well bottom plugged good


DRILLERS REMARKS:

DEPT. OF NATURAL RESOURCES
BUREAU OF LAND & WATER RESOURCES

DEC - 4 1984
RECEIVED

If well telescopes please
sketch and show depths.

GROUND LEVEL

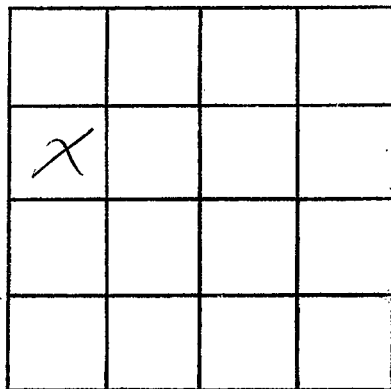

SECTION _____

Please indicate well location X.

ADDITIONAL INFORMATION

If more than one screen,
show locations of each on sketch.