

MISSISSIPPI DEPARTMENT OF NATURAL RESOURCES

Bureau of Land and Water Resources

Southport Mall

P.O. Box 10631

Jackson, Mississippi 39209

CARRIER WATER WELL DRILLERS LOG

Pearl River
2022K

SUB DIVISION & SON
WATER WELL SERVICE
ROUTE BOX
CARRIER WATER WELL DRILLERS LOG
PHONE 225-382-2222

SUB DIVISION & SON
WATER WELL SERVICE
ROUTE BOX
CARRIER, MISSISSIPPI

Pearl River
county well located

19____
date well completed

LANDOWNER: Mabel Perez

description of formations encountered	from	to
<u>Red shale</u>	<u>0</u>	<u>12</u>
<u>Red sand</u>	<u>12</u>	<u>30</u>
<u>Blue shale</u>	<u>30</u>	<u>265</u>
<u>Blue sand</u>	<u>265</u>	<u>300</u>
<u>Blue shale</u>	<u>300</u>	<u>460</u>
<u>Grey sand</u>	<u>460</u>	<u>484</u>

B.T. 1 Box 1898

Carrier Miss
(mailing address)

WELL LOCATION:
sec. 35 T. 3 N. R. 17 E.
S. W.

15 miles N of Pidogayne
(distance) (direction) (nearest town)

WELL PURPOSE: none
(home, irrigation, municipal, industrial)

WELL COMPLETION DATA:

(1) diameter (inches) 4 1/2"

(2) total depth (feet) 484

(3) static water level (feet) 20 below above top of ground.

(4) casing PVC, 484,
(material) (depth)

(size) If telescope see back.

(5) screen 10, 474
(length) (depth to top)

12, PVC
(size) (material)

(6) pump 1, 1350
(HP) (yield gpm)

Elect, JPH
(type power)

(7) electric log no
(yes or no)

(organization running log)

(8) how well bottom plugged sharp


DRILLERS REMARKS:

DEPT. OF NATURAL RESOURCES
BUREAU OF LAND & WATER RESOURCES

DEC - 4 1984
RECEIVED

If well telescopes please sketch and show depths.

GROUND LEVEL

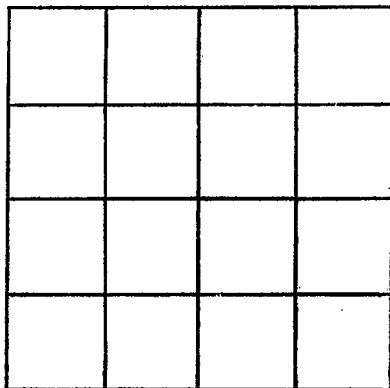

SECTION _____

Please indicate well location X.

ADDITIONAL INFORMATION

If more than one screen, show locations of each on sketch.