

MISSISSIPPI DEPARTMENT OF NATURAL RESOURCES

Bureau of Land and Water Resources

Southport Mall

P.O. Box 10631

Jackson, Mississippi 39209

WATER WELL DRILLERS LOG

Pearl River
R 2023

8/29

date well completed

1986 Bed penton Water

firm name

well

Pearl River

county well located

LANDOWNER: James Parrott

RT-1 Carriero Trss

(mailing address)

WELL LOCATION:

sec. 24 T. 3 N R. 17 E
S W
6 miles West of Carriero
(distance) (direction) (nearest town)

WELL PURPOSE: home
(home, irrigation, municipal, industrial)

WELL COMPLETION DATA:

- (1) diameter (inches) 4
- (2) total depth (feet) 572
- (3) static water level (feet) 125 below top of ground.
- (4) casing pvc, 572,
(material) (depth)
(size) if telescope see back.
- (5) screen 10, 502
(length) (depth to top)
12, pvc
(size) (material)
- (6) pump 1, 1200
(HP) (yield gpm)
Elect.
(type power)
- (7) electric log no
(yes or no)

(organization running log)

(8) how well bottom plugged standard
mark

DRILLERS REMARKS:

description of formations encountered

from to


<u>Red shale</u>	<u>0</u>	<u>30</u>
<u>Red sand</u>	<u>30</u>	<u>70</u>
<u>Blue shale</u>	<u>70</u>	<u>205</u>
<u>Grey sand</u>	<u>205</u>	<u>275</u>
<u>Blue shale</u>	<u>275</u>	<u>470</u>
<u>Grey sand</u>	<u>470</u>	<u>572</u>

RECEIVED
JUN 12 1987

Department of Natural Resources
Bureau of Land & Water Resources

If well telescopes please sketch and show depths.

GROUND LEVEL

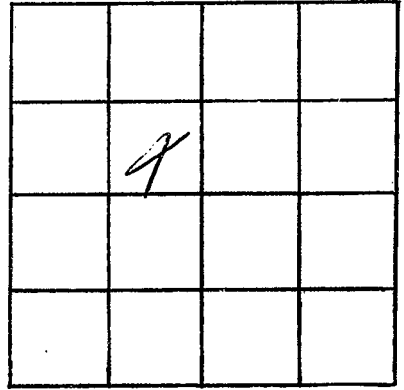

SECTION _____

Please indicate well location X.

ADDITIONAL INFORMATION

If more than one screen, show locations of each on sketch.