

MISSISSIPPI DEPARTMENT OF NATURAL RESOURCES
Bureau of Land and Water Resources
 Southport Mall
 P.O. Box 10631
 Jackson, Mississippi 39209
WATER WELL DRILLERS LOG

Pearl River
K 2024

3/19
 date well completed

1987 Bud Penton
 firm name

Pearl River
 county well located

LANDOWNER: Mike Kennedy
RT-1 Box Circle 2
Carriere Miss
 (mailing address)

WELL LOCATION:
 sec 24 T 3 N R 17 E
6 miles W of Carriere
 (distance) (direction) (nearest town)

WELL PURPOSE: Home
 (home, irrigation, municipal, industrial)

WELL COMPLETION DATA:

- (1) diameter (inches) 4
- (2) total depth (feet) 547
- (3) static water level (feet) 60 below above top of ground.
- (4) casing pvc, 547,
 (material) (depth)
 (size) if telescope see back.
- (5) screen 10, 537,
 (length) (depth to top)
12, pvc
 (size) (material)
- (6) pump 1, 650,
 (HP) (yield gpm)
Elect
 (type power)
- (7) electric log no
 (yes or no)

(organization running log)

(8) how well bottom plugged Shard
Shard

DRILLERS REMARKS:

description of formations encountered	from	to
<u>Red shale</u>	<u>0</u>	<u>70</u>
<u>Blue shale</u>	<u>70</u>	<u>175</u>
<u>Blue sand</u>	<u>175</u>	<u>230</u>
<u>Blue shale</u>	<u>230</u>	<u>280</u>
<u>Blue sand</u>	<u>280</u>	<u>320</u>
<u>Blue shale</u>	<u>320</u>	<u>500</u>
<u>Gray sand</u>	<u>500</u>	<u>557</u>


RECEIVED

JUN 12 1997

Department of Natural Resources
 Bureau of Land & Water Resources

If well telescopes please sketch and show depths.

GROUND LEVEL

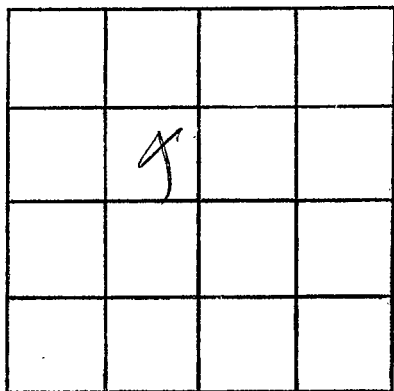

SECTION _____

Please indicate well location X.

ADDITIONAL INFORMATION

If more than one screen,
show locations of each on sketch.