

MISSISSIPPI DEPARTMENT OF NATURAL RESOURCES

Bureau of Land and Water Resources

Southport Mall

P.O. Box 10631

Jackson, Mississippi 39209

WATER WELL DRILLERS LOG

P. RIVER
K 2027

1/19/89
date well completed

Superior Water Drilling
firm name

Preal River
county well located

LANDOWNER: Thompson Cattle Co.

description of formations encountered

from

to

Hay 26

Top Soil

0

3"

Poplarville Ms 39470
(mailing address)

yellow clay

3'

18'

yellow + Red clay

18'

38'

Fine Tan Sand

30'

35'

yellow clay

35'

58'

med + coarse tan sand

50'

90'

Fine + med tan sand

90'

110'

Coarse Sand + Gravel

110'

WELL LOCATION:

sec. 9 T. 3 N. R. 17 E. S. W.
1 1/2 miles W of Poplarville
(distance) (direction) (nearest town)

WELL PURPOSE: Farm
(home, irrigation, municipal, industrial)

WELL COMPLETION DATA:

(1) diameter (inches) 4
(2) total depth (feet) 130
(3) static water level (feet) 63 below top of ground.

(4) casing PVC, 130 (depth)
(material)

(size) If telescope see back.

(5) screen 10, 120 (length) (depth to top)

4" 012, PVC Slot (size) (material)

(6) pump 1 1/2, 30 (HP) (yield gpm)

220V (type power)

(7) electric log (yes or no)

(organization running log)

(8) how well bottom plugged BW


RECEIVED
FEB 10 1989

Department of Natural Resources
Bureau of Land & Water Resources

DRILLERS REMARKS:

If well telescopes please sketch and show depths.

GROUND LEVEL

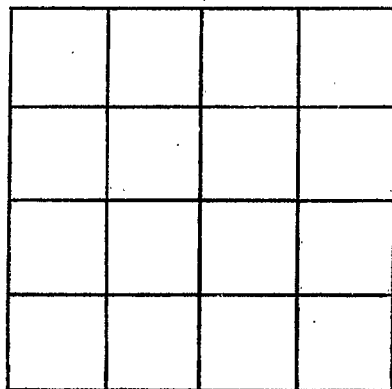

SECTION _____

Please indicate well location X.

ADDITIONAL INFORMATION

If more than one screen,
show locations of each on sketch.