

MISSISSIPPI DEPARTMENT OF NATURAL RESOURCES

Bureau of Land and Water Resources

Southport Mall

P.O. Box 10631

Jackson, Mississippi 39209

WATER WELL DRILLERS LOG

P. R. W. R.
K 2030

6/28
date well completed

91 Budgeton
firm name

Pearl River
county well located


LANDOWNER: John Ramsey
Main 43 North
(mailing address)

description of formations encountered	from	to
Red shale	0	10
White shale	10	195
Gravel sand	195	240

WELL LOCATION:
sec 36 T 3 N R 17 E
S W
2 miles S of Cross Rd
(distance) (direction) (nearest town)

WELL PURPOSE: home
(home, irrigation, municipal, industrial)

- WELL COMPLETION DATA:
- (1) diameter (inches) 14
 - (2) total depth (feet) 240
 - (3) static water level (feet) 133 below top of ground.
 - (4) casing PVC, 240 (material), (depth)
 - (size) If telescope see back.
 - (5) screen 10 (length), 230 (depth to top)
 - (size) PVC (material)
 - (6) pump 3/4 (HP), 100 (yield gpm)
 - Elect (type power)
 - (7) electric log 270 (yes or no)
 - (organization running log)
 - (8) how well bottom plugged sand

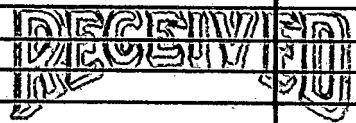


JUN 7 1991

Dept. of Environmental Quality
Bureau of Land & Water Resources

DRILLERS REMARKS:

If well telescopes please sketch and show depths.

GROUND LEVEL

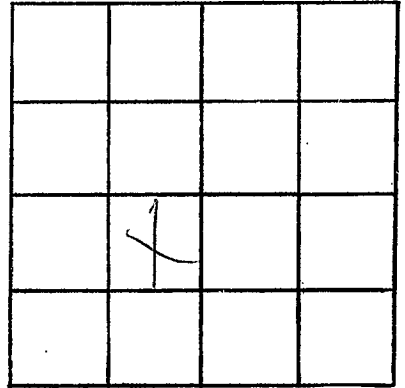

SECTION _____

Please indicate well location X.

ADDITIONAL INFORMATION

If more than one screen,
show locations of each on sketch.