

**MISSISSIPPI DEPARTMENT OF ENVIRONMENTAL QUALITY**  
Bureau of Land and Water Resources

P. O. Box 10631  
Jackson, MS 39289-0631  
**WATER WELL DRILLERS LOG**

COUNTY WELL LOCATED <i>Pearl River</i>	
WELL NUMBER <i>2034</i>	CODED
DATE WELL COMPLETED <i>2/24/95</i>	

PERMIT NUMBER <i>0-508</i>
NAME OF DRILLING FIRM <i>Jordan Well Serv.</i>

NAME & MAILING ADDRESS OF LANDOWNER <i>Ricky Traylor</i> <i>Bozlarville, Miss</i>			
WELL LOCATION: SEC	TOWNSHIP	RANGE	
<i>02</i>	<i>3</i>	<i>N</i>	<i>17</i>
		<i>S</i>	<i>W</i>
DISTANCE	DIRECTION	NEAREST TOWN	
<i>2</i> Miles	<i>E</i>	<i>Bozlarville LA.</i>	
OTHER LANDMARK			
WELL PURPOSE: <input checked="" type="checkbox"/> Home, <input type="checkbox"/> Irrigation, <input type="checkbox"/> Municipal, <input type="checkbox"/> Industrial, <input type="checkbox"/> Fish Pond, etc.			

<b>PUMP DATA</b>		
PUMP TYPE (Circle One): <input checked="" type="radio"/> Submersible <input type="radio"/> Turbine, <input type="radio"/> Jet <input type="radio"/> Flowing Well, Other (Describe) _____		
POWER TYPE (Circle One): <input checked="" type="radio"/> Electric, <input type="radio"/> Tractor, <input type="radio"/> Diesel, <input type="radio"/> Gasoline, <input type="radio"/> Butane, Other (Describe) _____    H/P <i>1/2</i>		
Pump Capacity (GPM) <i>10</i>	No. of Stages <i>8</i>	Setting Depth  <b>FT.</b>
PUMP TEST		
Well yielded _____ GPM with a drawdown of _____ ft. after _____ hours of pumping		

<b>WELL DATA</b>		
Well Depth <i>50</i>	Casing Diameter (In.) <i>4</i>	Casing Length (Ft.) <i>40</i>
Type of Casing <i>PVC</i>	Hole Depth <i>50</i>	Depth to Static Water Level <i>10</i>
TYPE OF COMPLETION: (Circle One or More): Gravel Packed,    Underreamed,    Telescoped, Natural Development,    Open Hole,    Other (Describe) <i>10ft. cement grout</i>		
Top of Lap Pipe or Reduction in Casing		
FEET    IF TELESCOPED OR MORE THAN ONE SCREEN: USE BACK PAGE		

<b>LOG DATA</b>	
TYPE OF LOG RUN (Circle One): <input type="radio"/> No Log Run, <input type="radio"/> Electric, <input type="radio"/> Gamma Ray, <input type="radio"/> Density, <input type="radio"/> Sonic, <input type="radio"/> Neutron, Other (Describe) _____	
Name of Organization Running Log	

<b>SCREEN DATA</b>		
Diameter - Inches <i>4</i>	Length - Feet <i>10</i>	Slot Size - Inches <i>.012</i>
Screen Type <i>PVC</i>	Depth to Bottom - Feet <i>40</i>	

<b>GEOLOGIC DATA (Office Use Only)</b>			
Surface Elev.	Geologic Unit	Unit Thickness	Depth to Top
Subs. SWL	Date	Analysis	Aquifer Test


Driller's Remarks

DESCRIPTION OF FORMATIONS ENCOUNTERED	FROM	TO
<i>top soil</i>	<i>0</i>	<i>1</i>
<i>sandy clay</i>	<i>1</i>	<i>10</i>
<i>sand</i>	<i>10</i>	<i>50</i>

FORMATIONS (Continued)	FROM	TO
<b>RECEIVED</b>		
<b>MAR 10 1995</b>		
Dept. of Environmental Quality Office of Land & Water Resources		
IF MORE SPACE IS NEEDED, USE BACK		

If well telescopes please  
sketch and show depths.

GROUND LEVEL

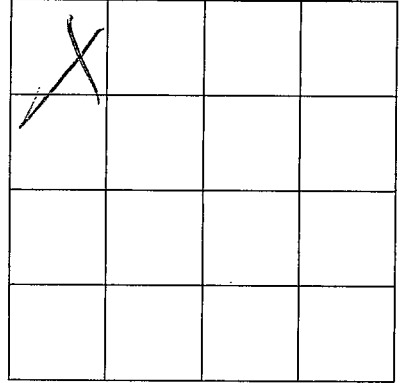

SECTION 2

Please indicate well location X.

ADDITIONAL INFORMATION

If more than one screen,  
show location of each on sketch.