

Pearl River.  
L 2  
6-68

MISSISSIPPI  
BOARD OF WATER COMMISSIONERS  
416 North State Street  
Jackson, Mississippi 39201

CODED

WATER WELL DRILLERS LOG

CODED

NEEL LUMPKEN WELL DRILLING SERVICE  
P. O. BOX 117

July 2 1968  
date well completed

CARRIERS, MISS.  
firm name

Pearl River  
county well located

LANDOWNER: St. Regis  
Paper Co.  
(mailing address)

description of formations encountered	from	to
surface clay	0	90
band, very fine	90	115
Blue clay	115	300
Good sand	300	342

WELL LOCATION:  
sec. 2 T. 3 N. R. 11 E.  
1/2 miles South of Ripleyville  
(distance) (direction) (nearest town)

WELL PURPOSE: Paper wood yard  
(home, irrigation, municipal, industrial)

WELL COMPLETION DATA:

(1) diameter (inches) 2  
(2) total depth (feet) 342  
(3) static water level (feet) 110' below top of ground.  
(4) casing galv. 331' (material) (depth)  
2" (size) if telescope see back.  
(5) screen 5' (length) (depth to top)  
2" St. Steel (size) (material)  
(6) pump 1 350 gpm (HP) (yield gpm)  
electric (type power)  
(7) electric log No. (yes or no)  
(organization running log) Johnson  
(8) how well bottom plugged B.P. Valve


CODED

MISSISSIPPI BOARD OF WATER COMMISSIONERS  
JULY 25 1968

DRILLERS REMARKS:

If well telescopes please sketch and show depths.

GROUND LEVEL

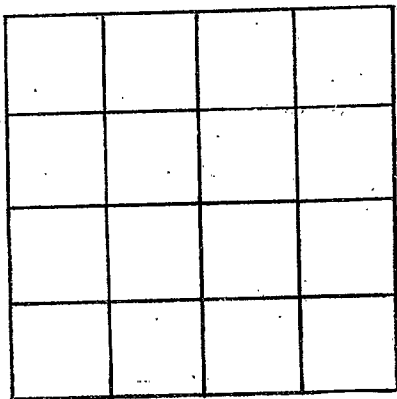

SECTION \_\_\_\_\_

Please indicate well location X.

ADDITIONAL INFORMATION

If more than one screen, show locations of each on sketch.