

PEARL RIVER
L-8
7-5-71

MISSISSIPPI
 BOARD OF WATER COMMISSIONERS
 416 North State Street
 Jackson, Mississippi 39201

CODED

WATER WELL DRILLERS LOG

7-5 1971 Horace A Poole Pearl River
 date well completed firm name county well located

LANDOWNER: John W Smith
RH 3 Poplarville
MISS
 (mailing address)

description of formations encountered	from	to
<u>SURFACE CLAY</u>	<u>0</u>	<u>10</u>
<u>CLAY</u>	<u>10</u>	<u>20</u>
<u>SILT</u>	<u>20</u>	<u>30</u>
<u>STONE SAND</u>	<u>30</u>	<u>100</u>
<u>WATER SAND</u>	<u>100</u>	<u>120</u>

WELL LOCATION:
 sec 35 T 3 N R 16 E
8 miles S of Poplarville
 (distance) (direction) (nearest town)

WELL PURPOSE: FARM
 (home, irrigation, municipal, industrial)

WELL COMPLETION DATA:

(1) diameter (inches) 2

(2) total depth (feet) 120'

(3) static water level (feet) 60 below top of ground. above

(4) casing Pvc 120'
 (material) (depth)
2" if telescope see back.
 (size)

(5) screen 5 ft 120'
 (length) (depth to top)
010 Pvc
 (size) (material)

(6) pump 1 5
 (HP) (yield gpm)
GL
 (type power)

(7) electric log NO
 (yes or no)

(organization running log)

CODED

Aug 2 1971


MISS. Bd. of
 WATER COMMISSIONERS

(8) how well bottom plugged
BACK WASH VALVE

DRILLERS REMARKS:

If well telescopes please sketch and show depths.

GROUND LEVEL

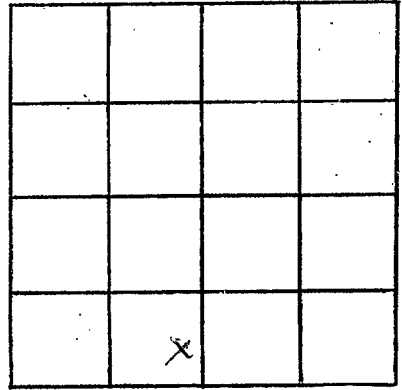

SECTION 35

Please indicate well location X.

ADDITIONAL INFORMATION

If more than one screen,
show locations of each on sketch.