

WATER WELL DRILLING

Pearl R.
AL-11

Date: Oct 11, 1962, Driller: POUPART County: River
 10-11-62 (Name)

(1) Owner of Land: BEN GRIFFIN
 (Name)
RADIO STATION - POPLARVILLE
 (Address)
 (2) Location: 1/4, 1/4, Sec. 1 T3 R16
2 miles South of POPLARVILLE
 (distance) (direction) (Nearest Town)
 (3) Topography: (Hilly) (Flat) (Level)
 (4) Purpose of Well: DOMESTIC
 (Domestic Irrigation, Municipal, Industrial, Other)


Description & Color of Materials Sand, Clay, Red Clay, etc.	Thick- ness Feet	Depth Feet
<u>Red Clay</u>	<u>20</u>	<u>20</u>
<u>" "</u>	<u>10</u>	<u>30</u>
<u>FINE SAND</u>	<u>10</u>	<u>40</u>
<u>PARK</u>		
<u>WHITE CLAY</u>	<u>10</u>	<u>210</u>
<u>Blue Clay</u>	<u>84</u>	<u>294</u>
<u>FINE SAND</u>	<u>21</u>	<u>315</u>
<u>Coarse SAND</u>		<u>342</u>
<u>Gray with alk</u>		
<u>peppes</u>		

Information upon completion of well:

(1) Diameter 2 inches.
 (2) Total Depth 342 feet.
 (3) Water Level 106 feet below top of ground.
 (4) Cased to _____, Size _____
 (5) Screen: Size 208, Length 10'
 (6) Were any formations sealed against pollution?
 _____ yes, _____ no.

If YES depth of formation _____
 Why _____
 Drillers Remarks: _____

CODED

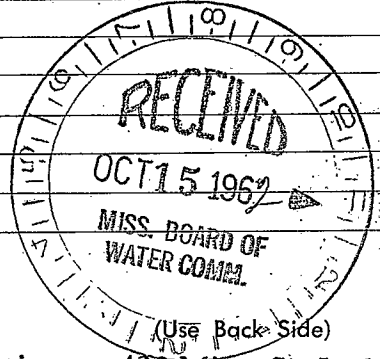

Well No.

