

Pearl R.

L-12 WATER WELL DRILLERS LOG

7-26-63

Date: JULY 26 1963, Driller: POUPART

(Name)

PEARL
COUNTY
REWER
CODED

(1) Owner of Land: HOMER LOTT
(Name)
DERBY PLACE
(Address)

(2) Location: 1/4, 1/4, Sec. 22 T³⁵R¹⁶,
2 miles NORTH, of DERBY
(distance) (direction) (Nearest Town)

(3) Topography: _____
(Hilly) (Flat) (Level)

(4) Purpose of Well: DOMESTIC
(Domestic Irrigation
Municipal, Industrial, Other)

Description & Color of Materials Sand, Clay, Red Clay, Shell, etc.	Thick- ness Feet	Depth Feet
<u>SAND + white</u>		
<u>clay</u>	<u>50</u>	
<u>Blue Clay</u>	<u>10</u>	<u>60</u>
<u>Blue SAND</u>	<u>20</u>	<u>80</u>
<u>White SAND</u>	<u>32</u>	<u>112</u>

Information upon completion of well:

(1) Diameter 2 inches.

(2) Total Depth 112 feet.

(3) Water Level 80 feet below top of ground.

(4) Cased to _____, Size _____

(5) Screen: Size 0/0, Length 6'


(6) Were any formations sealed against pollution?
_____ yes, _____ no.

If YES depth of formation _____

Why _____

Drillers Remarks: _____

CODED

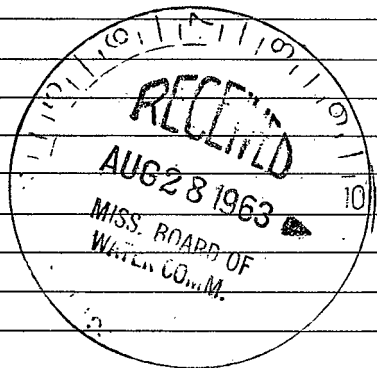

(Use Back Side)

Well No.

Handwritten notes at the top of the page, including a large heading that appears to be "Introduction" and several lines of text.

Main body of handwritten text, consisting of several paragraphs of notes.

Bottom section of handwritten text, possibly a conclusion or a list of items.