

CODED

PEARL RIVER  
L 16  
11-9-71

MISSISSIPPI  
BOARD OF WATER COMMISSIONERS  
416 North State Street  
Jackson, Mississippi 39201

MAR 9 1972

WATER WELL DRILLERS LOG

11-9-1971 Neil Lumper, Well Pearl River  
date well completed 1971 firm name Drilling Service county well located

LANDOWNER: Ray M. Swartz  
919 Gravier St.  
New Orleans, La.  
(mailing address)

description of formations encountered	from	to
Surface clay	0	20
✓ sand	20	126

WELL LOCATION:  
sec. 6 T. 3 S. R. 16 E. W.  
6 miles west of Poplarville  
(distance) (direction) (nearest town)

Blue clay	126	300
Good sand	300	384

WELL PURPOSE: Summer camp  
(home, irrigation, municipal, industrial)

- WELL COMPLETION DATA:
- (1) diameter (inches) 2"
  - (2) total depth (feet) 384'
  - (3) static water level (feet) 40' below top of ground.
  - (4) casing galv. (material), (depth) 20' (size) If telescope see back.
  - (5) screen 5' (length), (depth to top) 2" (size), SS. (material)
  - (6) pump 1/2 (HP), 450 gpm (yield gpm), electric (type power)
  - (7) electric log no (yes or no)


CODED

(organization running log)  
(8) how well bottom plugged Johnson P P Valve

DRILLERS REMARKS:

If well telescopes please sketch and show depths.

GROUND LEVEL

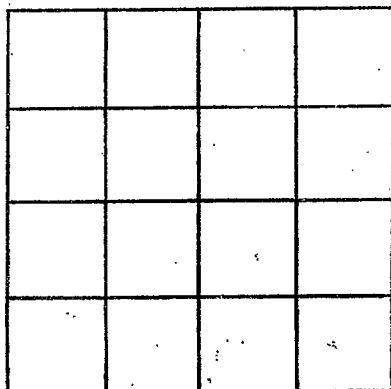

SECTION \_\_\_\_\_

Please indicate well location X.

ADDITIONAL INFORMATION

If more than one screen,  
show locations of each on sketch.