

Pearl River
L 19
5-15-72

MISSISSIPPI
 BOARD OF WATER COMMISSIONERS
 416 North State Street
 Jackson, Mississippi 39201

CODED

WATER WELL DRILLERS LOG

5-15 1972 Earl Ponton water well Sher. Pearl River
 date well completed firm name county well located

LANDOWNER:
Mr. Ed. Baughman
Derby Miss.
 (mailing address)

description of formations encountered	from	to
<u>Red clay</u>	<u>0</u>	<u>14</u>
<u>med white sand</u>	<u>14</u>	<u>55</u>

WELL LOCATION:
 sec. 27 T 3 N R 16 E
1 miles South of Derby
 (distance) (direction) (nearest town)

WELL PURPOSE: Home
 (home, irrigation, municipal, industrial)

- WELL COMPLETION DATA:
- (1) diameter (inches) 4 1/2"
 - (2) total depth (feet) 55'
 - (3) static water level (feet) 18 below above top of ground.
 - (4) casing P.V.C. 50'
 (material) (depth)
2" if telescope see back.
 (size)
 - (5) screen 5' 50'
 (length) (depth to top)
2" P.V.C.
 (size) (material)
 - (6) pump 1/2 450
 (HP) (yield gpm)
Elect.
 (type power)
 - (7) electric log NO
 (yes or no)
 (organization running log)
 - (8) how well bottom plugged shoe

CODED


111-21-1312

MISS. BO. OF
 WATER COMMISSIONERS

DRILLERS REMARKS:

If well telescopes please sketch and show depths.

GROUND LEVEL

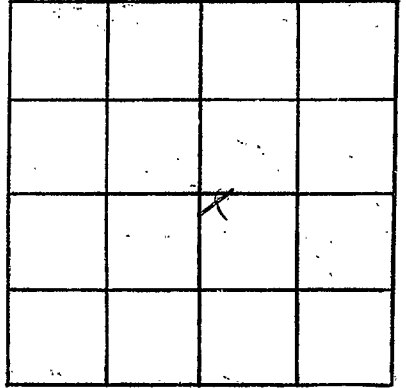

SECTION 27

Please indicate well location X.

ADDITIONAL INFORMATION

If more than one screen, show locations of each on sketch.