

Pearl River
 L 21
 6-69

MISSISSIPPI
 BOARD OF WATER COMMISSIONERS
 416 North State Street
 Jackson, Mississippi 39201

CODED

WATER WELL DRILLERS LOG

6-27 1969 HORACE A POOLE PEARL RIVER
 date well completed firm name county well located


LANDOWNER: <u>H. S. BAZOR</u>	description of formations encountered	from	to
<u>RT#3</u>			
<u>POPLARVILLE MISS</u> (mailing address)	<u>SANDY Clay</u>	<u>0</u>	<u>15</u>
	<u>SAND</u>	<u>15</u>	<u>22</u>
	<u>CLAY</u>	<u>22</u>	<u>105</u>
	<u>SILT</u>	<u>105</u>	<u>126</u>
	<u>CLAY</u>	<u>126</u>	<u>190</u>
	<u>SAND</u>	<u>190</u>	<u>305</u>
WELL LOCATION:			
sec <u>30</u> T <u>3</u> N R <u>16</u> E <div style="display: flex; justify-content: space-around; width: 100%;"> (S) (W) </div> <u>7</u> miles <u>SOUTH</u> of <u>Poplarville</u> (distance) (direction) (nearest town)			
WELL PURPOSE: <u>HOME</u> (home, irrigation, municipal, industrial)			
WELL COMPLETION DATA:			
(1) diameter (inches) <u>4"</u>			
(2) total depth (feet) <u>205</u>			
(3) static water level (feet) <u>8</u> below above top of ground.			
(4) casing <u>PVC</u> , <u>200</u> , (material) (depth)			
<u>2"</u> (size) If telescope see back.			
(5) screen <u>5'</u> , <u>200</u> (length) (depth to top)			
<u>2" O.D.</u> , <u>PVC</u> (size) (material)			
(6) pump <u>1/2</u> , <u>5</u> (HP) (yield gpm)			
<u>Elec</u> (type power)			
(7) electric log <u>no</u> (yes or no)			
<u>(organization running log)</u>			
(8) how well bottom plugged <u>CRAYON MARRS B/W/N</u>			
DRILLERS REMARKS:			

JUL 14 1969

MISS. Bd. of
 WATER COMMISSIONERS

If well telescopes please sketch and show depths.

GROUND LEVEL

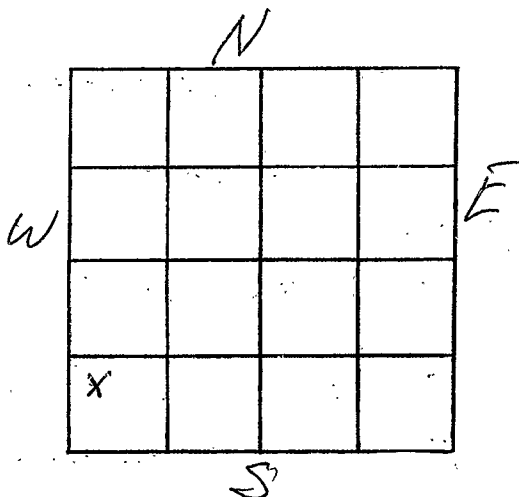

SECTION 30

Please indicate well location X.

ADDITIONAL INFORMATION

If more than one screen, show locations of each on sketch.