

CODED

Pearl River
L 22
6-20-69

MISSISSIPPI
BOARD OF WATER COMMISSIONERS
416 North State Street
Jackson, Mississippi 39201

WATER WELL DRILLERS LOG

June 20 1969 HAROLD WOODWARD PEARL RIVER
date well completed firm name county well located
WATER WELL DRILLING

LANDOWNER: BERKLEY
BURVE
W.B. Poplarville, Miss
(mailing address)

description of formations encountered	from	to
fine brown sand	0	18
choose brown sand	19	35
15 to 24 sand		
white clay		
choose white sand	80	105

WELL LOCATION:
sec. 6 T. 3 N R. 16 E
3 3/4 S W
(distance) miles (direction) of (nearest town)

WELL PURPOSE: HOME & STOCK
(home, irrigation, municipal, industrial)

- WELL COMPLETION DATA:
- (1) diameter (inches) 4"
 - (2) total depth (feet) 105'
 - (3) static water level (feet) 80 below above top of ground.
 - (4) casing plastic 105' (material) (depth)
4" (size) if telescope see back.
 - (5) screen 15' 90' (length) (depth to top)
4" (size) plastic (material)
 - (6) pump 2 (HP) 3.5 gpm (yield gpm)
230 AC (type power)
 - (7) electric log NO (yes or no)
Self (organization running log)
 - (8) how well bottom plugged B.W. Hub

JUN 27 1969

MISS. BD. OF
WATER COMMISSIONERS

DRILLERS REMARKS: 4.480 per hour was the pumping rate

If well telescopes please sketch and show depths.


GROUND LEVEL

4" PVC plastic pipe

12 ft
to water

15' x 4" plastic well screen

If more than one screen, show locations of each on sketch.

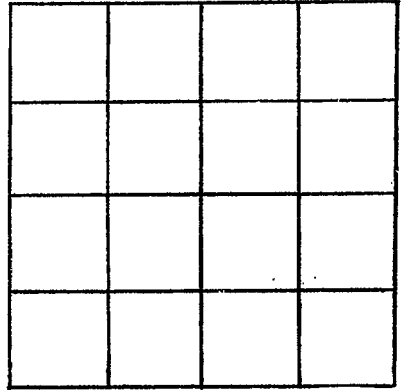

SECTION _____

Please indicate well location X.

ADDITIONAL INFORMATION

Multiple horizontal lines for additional information.