

PEARL RIVER

L 23

8-12-70

MISSISSIPPI BOARD OF WATER COMMISSIONERS
416 North State Street
Jackson, Mississippi 39201

CODED

WATER WELL DRILLERS LOG

8-12-1970 date well completed
Horace A. Poole firm name
Pearl River county well located

LANDOWNER: R.J. STEWART

Poplarville Miss
(mailing address)

WELL LOCATION:

sec. 18 T-3 N R-16 E
S W
7 miles SW of Pville
(distance) (direction) (nearest town)

WELL PURPOSE: FARM
(home, irrigation, municipal, industrial)

WELL COMPLETION DATA:

- (1) diameter (inches) 7"
- (2) total depth (feet) 135
- (3) static water level (feet) 80 below top of ground.
- (4) casing PVC 120 (material) (depth)
4" (size) if telescope see back.
- (5) screen 10' 120 (length) (depth to top)
4" (size) PVC (material)
- (6) pump 1 20 (HP) (yield gpm)
Elec (type power)
- (7) electric log no (yes or no)

(organization running log)

(8) how well bottom plugged
BAR & WASH VALVE

DRILLERS REMARKS:

description of formations encountered

from to

SURFACE CLAY	0	15
SANDY CLAY	15	40
SILT	40	60
SAND & SILT	60	80
SAND	80	100
SAND & PEABUCKE	100	135

CODED

SEP 4 1970

MISS. BD. OF WATER COMM.


1 1970

MISS. BD. OF WATER COMM.

①

If well telescopes please sketch and show depths.

GROUND LEVEL

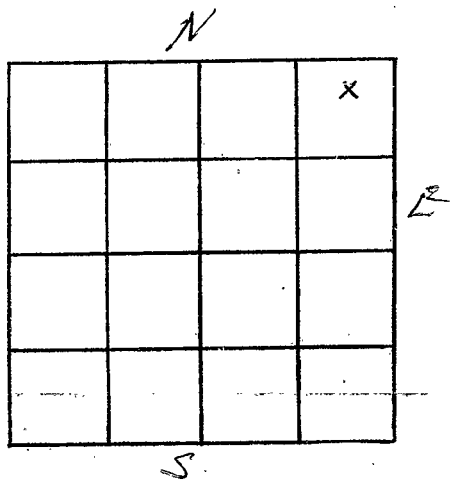

SECTION 18

Please indicate well location X.

ADDITIONAL INFORMATION

A series of horizontal lines for recording additional information.

If more than one screen, show locations of each on sketch.