

Pearl River  
L 25  
6-18-70

MISSISSIPPI  
BOARD OF WATER COMMISSIONERS  
416 North State Street  
Jackson, Mississippi 39201

**CODED**

WATER WELL DRILLERS LOG

June 18 1970 S + Swell Works Pearl River  
date well completed firm name county well located

LANDOWNER: J.C. Sadner

description of formations encountered

from

to

Poplarville  
Miss (mailing address)

top soil 0 2  
Clay 2 18  
Sand 18 45

WELL LOCATION:

32 3 16 E  
7 miles South of Poplarville  
(distance) (direction) (nearest town)

WELL PURPOSE: None  
(home, irrigation, municipal, industrial)

WELL COMPLETION DATA:

- (1) diameter (inches) 2 in
- (2) total depth (feet) 45
- (3) static water level (feet) 25 below top of ground.
- (4) casing PVC 35 (material) (depth)

**CODED**

(size) if telescope see back.

- (5) screen 16 35 (length) (depth to top)

2 in PVC (size) (material)

- (6) pump 1 5 (HP) (yield gpm)

F (type power)

- (7) electric log no (yes or no)

(organization running log)

- (8) how well bottom plugged B.W.

JUN 22 1970


MISS. BD. OF  
WATER

DRILLERS REMARKS:

none

If well telescopes please sketch and show depths.

GROUND LEVEL

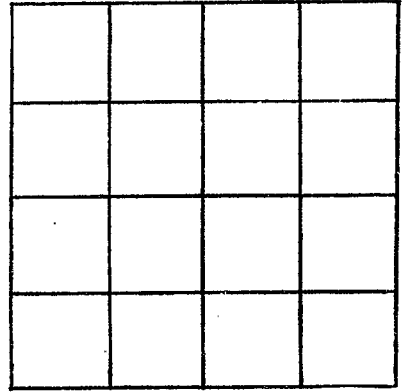

SECTION \_\_\_\_\_

Please indicate well location X.

ADDITIONAL INFORMATION

If more than one screen,  
show locations of each on sketch.