

MISSISSIPPI
BOARD OF WATER COMMISSIONERS
416 North State Street
Jackson, Mississippi 39201

CODED

WATER WELL DRILLERS LOG

Pearl River
L 26
6-18-70

6-18 1970 E. J. Swater well serv Pearl R. Riv.
date well completed firm name county well located

LANDOWNER:
Windy Hill Farm
Box 228 Poplarville miss
(mailing address)

description of formations encountered	from	to
<u>Red s. clay</u>	<u>0</u>	<u>14</u>
<u>Five Red sd.</u>	<u>14</u>	<u>24</u>
<u>White Clay</u>	<u>24</u>	<u>50</u>
<u>Blue Clay</u>	<u>50</u>	<u>70</u>
<u>White & yellow clay</u>	<u>70</u>	<u>132</u>
<u>Red med sd.</u>	<u>132</u>	<u>180</u>
<u>Blue Clay</u>	<u>180</u>	<u>220</u>
<u>Grey C. sd.</u>	<u>220</u>	<u>244</u>

WELL LOCATION:
sec. 9 T. 3 N. R. 16 E.
5 miles west of Poplarville
(distance) (direction) (nearest town)

WELL PURPOSE:
(home, irrigation, municipal, industrial)

WELL COMPLETION DATA:
(1) diameter (inches) 4.5
(2) total depth (feet) 244
(3) static water level (feet) 72 below top of ground.
(4) casing Cob. 239
(material) (depth)
(size) if telescope see back.
(5) screen 5' 239-44
(length) (depth to top)
2" S.S.
(size) (material)
(6) pump 1 400
(HP) (yield gpm)
Elect
(type power)
(7) electric log NO
(yes or no)
(organization running log)
(8) how well bottom plugged Shoe

CODED


JUL 28 1970

DRILLERS REMARKS:

MISS. BD. OF
WATER COMMISSIONERS

If well telescopes please sketch and show depths.

GROUND LEVEL

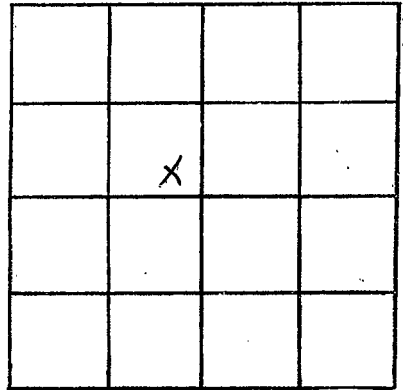

SECTION 2

Please indicate well location X.

ADDITIONAL INFORMATION

If more than one screen, show locations of each on sketch.