

Pearl River
L 27
6-28-70

MISSISSIPPI
BOARD OF WATER COMMISSIONERS
416 North State Street
Jackson, Mississippi 39201

CODED

WATER WELL DRILLERS LOG

6-28 1970 E & J water wellers Pearl River
date well completed firm name county well located

LANDOWNER:	description of formations encountered	from	to
Willie Ruth Lewis			
Rt 3 Box 213 Poplarville (mailing address) Miss.	white clay	25	48
WELL LOCATION:	white sd. w/ chert	48	59
sec. 26 T 3 N R 16 E 2 miles East of Derby (distance) (direction) (nearest town)	white clay	59	97
WELL PURPOSE: Home (home, irrigation, municipal, industrial)	Red Fine sd.	97	100
WELL COMPLETION DATA:	Blue clay	100	132
(1) diameter (inches) 4.5	Grey co. sd.	132	148
(2) total depth (feet) 195	med Blues sd.	148	160
(3) static water level (feet) 86 below top of ground.	Red sd co. & Gravel	160	195
(4) casing Galv. 190 (material) (depth)			
(size) if telescope see back.			
(5) screen 5' 190-5 (length) (depth to top)			
2" S.S. (size) (material)			
(6) pump 1 350 Pwr. Hv. (HP) (yield gpm)			
Elect (type power)			
(7) electric log NO (yes or no)			
(organization running log)			
(8) how well bottom plugged see			
DRILLERS REMARKS:			


CODED

JUL 28 1970

MISS. BD. OF
WATER COMMISSIONERS

If well telescopes please sketch and show depths.

GROUND LEVEL

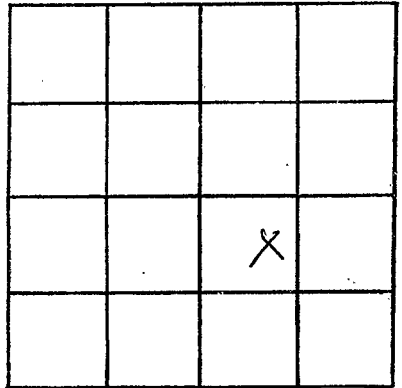

SECTION 26

Please indicate well location X.

ADDITIONAL INFORMATION

If more than one screen,
show locations of each on sketch.