

Pearl River
L28
7-16-70

MISSISSIPPI
BOARD OF WATER COMMISSIONERS
416 North State Street
Jackson, Mississippi 39201

CODED

WATER WELL DRILLERS LOG

7-16 1970 E.S. J. Water Well Svc. Pearl River
date well completed firm name county well located

LANDOWNER:		description of formations encountered	from	to
Harvey Adderson Rt 3 rd Poplarville Miss. (mailing address)				
		yellow & white clay	10	22
		Blue clay	22	99
		med. Blue clay	99	143
WELL LOCATION:				
sec. 27 th N R 16 th E 1/2 miles East Derby (distance) (direction) (nearest town)				
WELL PURPOSE: Home (home, irrigation, municipal, industrial)				
WELL COMPLETION DATA:				
(1) diameter (inches) 4 3/4				
(2) total depth (feet) 142				
(3) static water level (feet) 67 below top of ground.				
(4) casing Galv. 137. (material) (depth)				
(size) If telescope see back.				
(5) screen 5' 137-42 (length) (depth to top)				
2" 55. (size) (material)				
(6) pump 1 500 (HP) (yield gpm)				
Elect (type power)				
(7) electric log NO (yes or no)				
(organization running log)				
(8) how well bottom plugged Shoe				
DRILLERS REMARKS:				


CODED

JUL 28 1970

MISS. BD. OF
WATER COM. S.

If well telescopes please sketch and show depths.

GROUND LEVEL

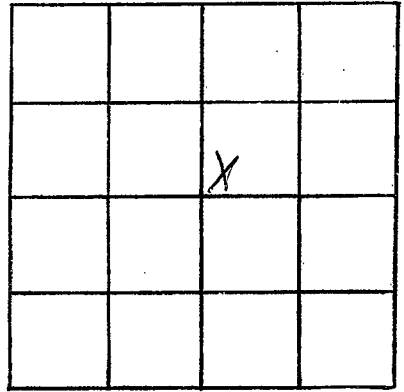

SECTION 27

Please indicate well location X.

ADDITIONAL INFORMATION

If more than one screen,
show locations of each on sketch.