

PEARL RIVER

L 30

10-15-70

MISSISSIPPI BOARD OF WATER COMMISSIONERS
416 North State Street
Jackson, Mississippi 39201

CODED

WATER WELL DRILLERS LOG

NEIL LUMPKIN WELL DRILLING SERVICE

P. O. BOX 117

CARRIERS, MISS

Pearl River

10-15-1970
date well completed

firm name

county well located

LANDOWNER: *George M. Love*

Paplarville, Miss.

Route 3
(mailing address)

description of formations encountered

from

to

Surface Clay 0 20
✓ sand 20 90

WELL LOCATION:

sec. 7 T. 3 R. 16

8 miles W of Paplarville
(distance) (direction) (nearest town)

WELL PURPOSE: home
(home, irrigation, municipal, industrial)

WELL COMPLETION DATA:

- (1) diameter (inches) 2"
- (2) total depth (feet) 90'
- (3) static water level (feet) 30 below above top of ground.
- (4) casing galv. (material), (depth)
2" (size) if telescope see back.
- (5) screen 5 (length), (depth to top)
2" (size), 5. Steel (material)
- (6) pump 1/2 (HP), 450 gpm. (yield gpm)
electric (type power)
- (7) electric log no (yes or no)

CODED

(organization running log)

(8) how well bottom plugged Johnson
back pressure valve


DRILLERS REMARKS:

DEC 14 1970

MISS. Bd. of WATER COMM.

If well telescopes please sketch and show depths.

GROUND LEVEL

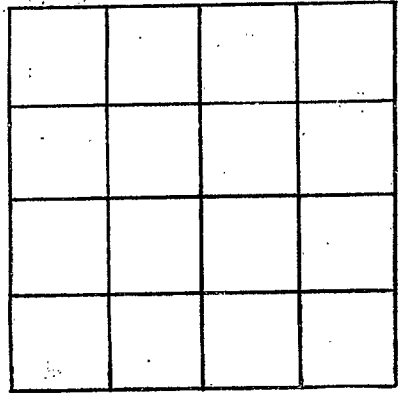

SECTION _____

Please indicate well location X.

ADDITIONAL INFORMATION

If more than one screen, show locations of each on sketch.