

PEARL RIVER
L 33
6-26-72

MISSISSIPPI
 BOARD OF WATER COMMISSIONERS
 416 North State Street
 Jackson, Mississippi 39201

CODED

WATER WELL DRILLERS LOG

NEIL LUMPKIN WELL DRILLING SERVICE

P. O. BOX 117

CARRIERS, MISS.

Pearl River

6-26-1972
 date well completed

county well located

LANDOWNER: *Charlie Bones*
Opplaville, Miss.
Route 3
 (mailing address)

description of formations encountered	from	to
<i>surface clay</i>	<i>0</i>	<i>10</i>
<i>sand & gravel</i>	<i>10</i>	<i>90</i>
<i>blue clay</i>	<i>90</i>	<i>180</i>
<i>hard sand</i>	<i>180</i>	<i>230</i>

WELL LOCATION:
 sec. *31* T. *3* S. R. *16* W.
5 miles *WEST* of *DERBY*
 (distance) (direction) (nearest town)

WELL PURPOSE: *home*
 (home, irrigation, municipal, industrial)

- WELL COMPLETION DATA:
- diameter (inches) *2"*
 - total depth (feet) *230*
 - static water level (feet) *10'* below above top of ground.
 - casing *plastic*
 (material) (depth)
2"
 (size) if telescope see back.
 - screen *5'*
 (length) (depth to top)
2" *plastic*
 (size) (material)
 - pump *1/2 shallow well*
 (HP) (yield gpm)
electric
 (type power)
 - electric log *no*
 (yes or no)
- (organization running log)

CODED

(8) how well bottom plugged *Johnson*
B.P. Valve


JUL 27 1972

DRILLERS REMARKS:
Flow

MISS. BD. OF
 WATER COMM.

If well telescopes please sketch and show depths.

GROUND LEVEL

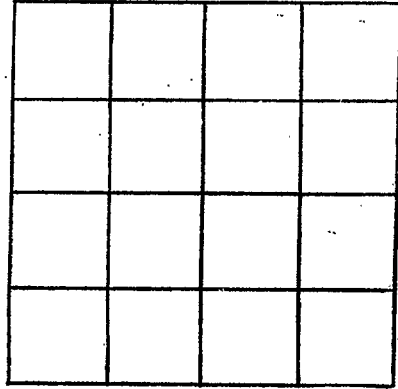

SECTION _____

Please indicate well location X.

ADDITIONAL INFORMATION

A series of horizontal lines for recording additional information, starting below the 'ADDITIONAL INFORMATION' header and extending to the bottom of the page.

If more than one screen, show locations of each on sketch.